


U. S. PUBLIC LAND SURVEY MONUMENT RECORD

SECTION 29 T 18 N, R 7 W, TOWN OF HOLLAND

LA CROSSE COUNTY

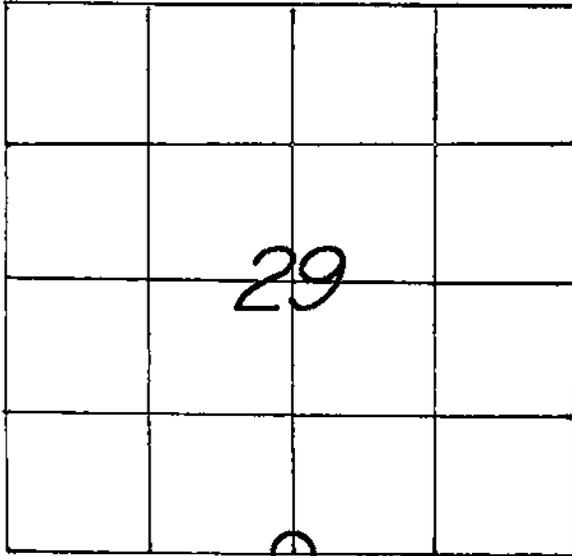

LOCATION OF LANDMARK

CREW: WILLIAM C. JUNG
 PETER F. FOLLANSBEE
 DATE: 10/28/2004

WISCONSIN COORDINATE SYSTEM

North

East

Theta Angle

Horiz. Order

Vert. Order

TYPE OF LANDMARK

1" IRON PIPE.

BEARINGS ARE REFERENCED TO

Describe any record evidence, monument evidence, testimonial evidence or any other material evidence you considered and whether the monument was found or restored through acceptance of an obliterated evidence location.

I found a pipe at the old occupied corner and accepted it as the best available evidence of the original government corner position. This pipe had been used as the corner in previous survey work.


Describe or show any material discrepancy between the location of the restored corner and that of the corner previously restored or reestablished.

NONE KNOWN.

U. S. PUBLIC LAND SURVEY MONUMENT RECORD

SECTION 29 T 18 N, R 7 W, TOWN OF HOLLAND

LA CROSSE COUNTY

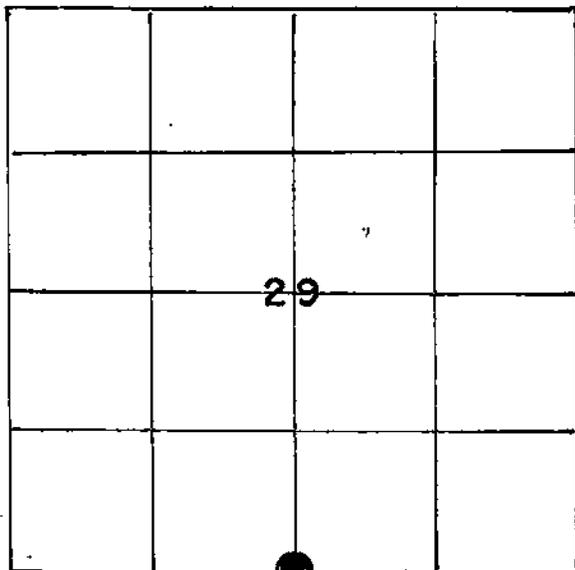

LOCATION OF LANDMARK

PHILIP SCHOLZE
8-06-03

| |
|------------------------------------|
| WISCONSIN COORDINATE SYSTEM |
| North |
| East |
| Theta Angle |
| Horiz. Order |
| Vert. Order |
| TYPE OF LANDMARK |
| BEARINGS ARE REFERENCED TO TRUE |

Describe any record evidence, monument evidence, testimonial evidence or any other material evidence you considered and whether the monument was found or restored through acceptance of an obliterated evidence location.

I ACCEPTED THE OLD OCCUPIED CORNER AS THE BEST AVAILABLE EVIDENCE OF THE ORIGINAL GOVERNMENT CORNER POSITION AND MONUMENTED IT WITH A 1" x 2' IRON PIPE. A 3" x 5' IRON MARKER POST WAS PLACED ON THE EAST SIDE OF THE MONUMENT.

Describe or show any material discrepancy between the location of the restored corner and that of the corner previously restored or reestablished.

NONE KNOWN

