


U. S. PUBLIC LAND SURVEY MONUMENT RECORD

SECTION 30 T 18 N, R 7 W, TOWN OF HOLLAND

LA CROSSE COUNTY

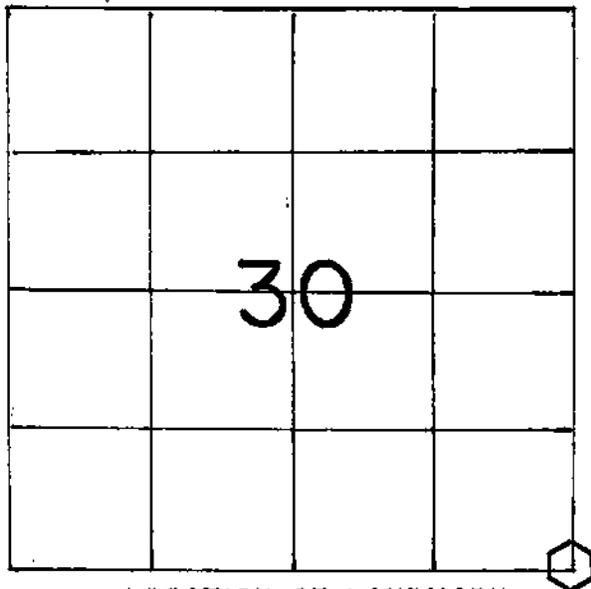

LOCATION OF LANDMARK

WISCONSIN COORDINATE SYSTEM

North

East

Theta Angle

Horiz. Order

Vert. Order

TYPE OF LANDMARK

Brass cap Lunde marker.

BEARINGS ARE REFERENCED TO

True North.

Crew: WILLIAM C. JUNG
 PETER F. FOLLANSBEE
 Date: 4/03/1995

Describe any record evidence, monument evidence, testimonial evidence or any other material evidence you considered and whether the monument was found or restored through acceptance of an obliterated evidence location.

I found an iron pipe at the corner which had been used in previous survey work. I've accepted this pipe as the best available evidence of the original corner position, removed it, and replaced it with a brass capped Lunde marker. The location also fits the occupied location.

Describe or show any material discrepancy between the location of the restored corner and that of the corner previously restored or reestablished.

None Known.

