


U. S. PUBLIC LAND SURVEY MONUMENT RECORD

SECTION 30 T 18 N, R 7 W, TOWN OF HOLLAND
 LA CROSSE COUNTY

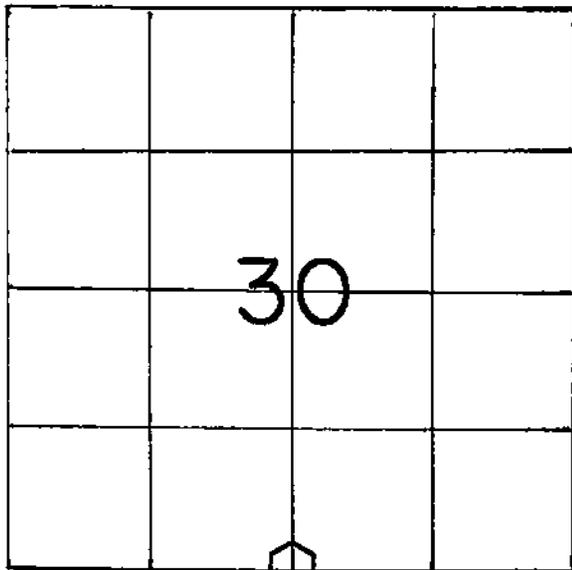

LOCATION OF LANDMARK

WISCONSIN COORDINATE SYSTEM	
North	
East	
Theta Angle	
Horiz. Order	
Vert. Order	
TYPE OF LANDMARK	
Brass Cap Lunde Marker.	
BEARINGS ARE REFERENCED TO	
True North.	

Crew: WILLIAM C. JUNG
 PETER F. FOLLANSBEE

Date: 6/20/1995

Describe any record evidence, monument evidence, testimonial evidence or any other material evidence you considered and whether the monument was found or restored through acceptance of an obliterated evidence location.

I found an iron bar at the corner which had been used in previous survey work. I've accepted this bar as the best available evidence of the original corner position, removed it, and replaced it with a brass capped Lunde marker. The location also fits the occupied location.

Describe or show any material discrepancy between the location of the restored corner and that of the corner previously restored or reestablished.

None Known.

