


U. S. PUBLIC LAND SURVEY MONUMENT RECORD

SECTION 30 T 18 N, R 7 W, TOWN OF HOLLAND
 LA CROSSE COUNTY

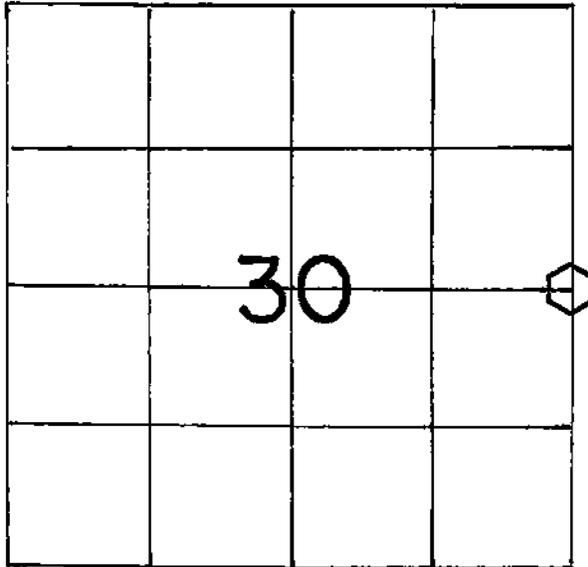

LOCATION OF LANDMARK

Crew: WILLIAM C. JUNG
 PETER F. FOLLANSBEE
 Date: 4/05/1995

WISCONSIN COORDINATE SYSTEM
North
East
Theta Angle
Horiz. Order
Vert. Order
TYPE OF LANDMARK
Brass cap Lunde marker.
BEARINGS ARE REFERENCED TO
True North.

Describe any record evidence, monument evidence, testimonial evidence or any other material evidence you considered and whether the monument was found or restored through acceptance of an obliterated evidence location.

I found an iron pipe at the corner which had been used in previous survey work. I've accepted this pipe as the best available evidence of the original corner position, removed it, and replaced it with a brass capped Lunde marker. The location also fits the occupied location.

Describe or show any material discrepancy between the location of the restored corner and that of the corner previously restored or reestablished.


None Known.

RECORD OF DURABLE WITNESS MONUMENTS

NO	DESCRIPTION	MAGNETIC	
		BEARING	DISTANCE
1	Set P.K. Nail in SE-side 8" Hickory	S 54° W	49.80 Ft.
2	Set P.K. Nail in NW-side multi-trunk Maple	S 27° W	49.69 Ft.
3	Ex. P.K. Nail in E.-side double Hickory	S 09° E	39.08 Ft.
4	Set P.K. Nail in W.-side 30" Burr Oak	N 16° E	Sl.=72.35'

E. 1/4-Cor., Sec. 30-18-7.
 Set brass cap Lunde marker to replace an iron pipe. Buried a Wine bottle with the corner and set a sign & post on the SE-side.

EXISTING P.K. NAIL IN POWER POLE 4.27 FT. TO THE NORTH.

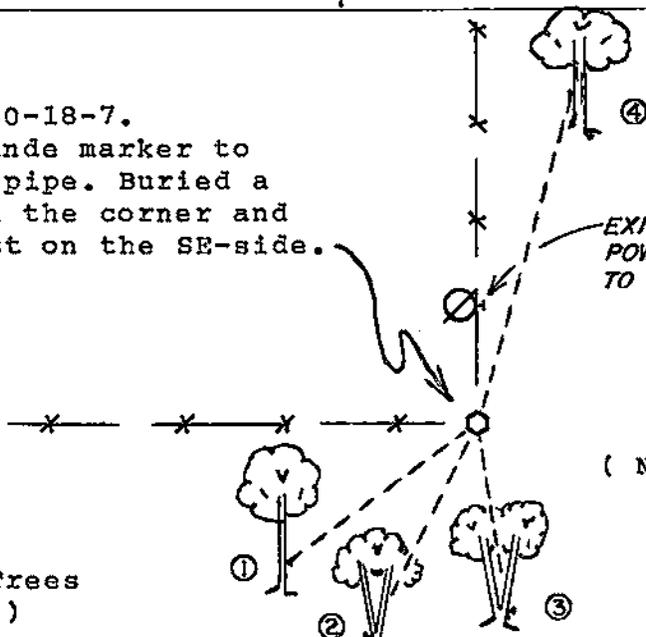

(Not to scale)

(Note: all Bearing Trees are unblazed.)


PLAN VIEW DRAWING OF REFERENCE TIES

MAP SHOWING DISTANCE AND DIRECTION TO OTHER PUBLIC LAND SURVEY CORNERS USED FOR REESTABLISHING THE CORNER (not to scale)

NE-Cor., Sec. 30-18-7.
 Iron Pipe.

E. 1/4-Cor., Sec. 30-18-7.
 Lunde marker.


SE-Cor., Sec. 30-18-7.
 Lunde marker.

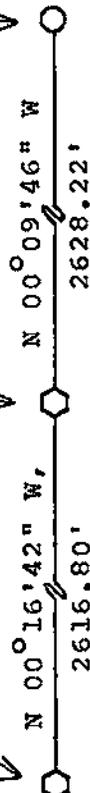

I, William C. Jung, County Surveyor
 HEREBY CERTIFY THAT THE CORNER LOCATION SHOWN ON THIS RECORD WAS DETERMINED BY ME OR UNDER MY DIRECTION AND CONTROL AND THAT THIS U. S. PUBLIC LAND SURVEY MONUMENT RECORD IS CORRECT AND COMPLETE TO THE BEST OF MY KNOWLEDGE AND BELIEF.

William C. Jung
 Signature

7/7/95
 Date

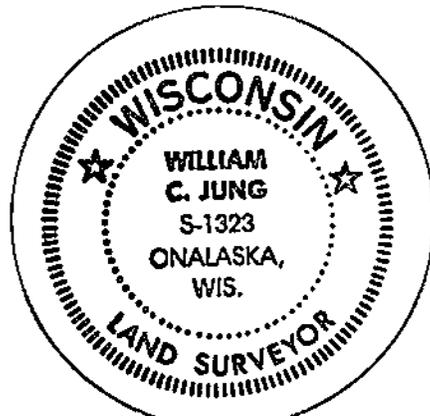

Seal