


21807312000

U. S. PUBLIC LAND SURVEY MONUMENT RECORD

SECTION 31 T 18 N, R 7 W, TOWN OF HOLLAND

LA CROSSE COUNTY

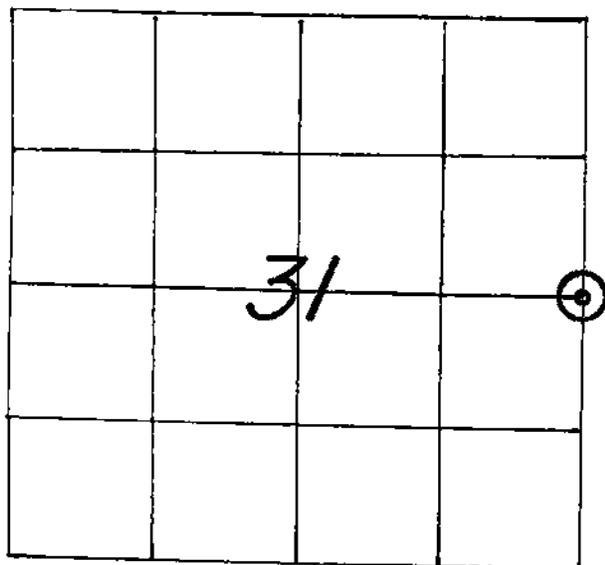

LOCATION OF LANDMARK

CREW: **WILLIAM C. JUNG**
PETER F. FOLLANSBEE

DATE: **8/02/2007**

WISCONSIN COORDINATE SYSTEM

North

East

Theta Angle

Horiz. Order

Vert. Order

TYPE OF LANDMARK

3/4" x 24" IRON BAR WITH A RED PLASTIC CAP.

BEARINGS ARE REFERENCED TO
ASSUMED NORTH AS PER SECTION DATA.

Describe any record evidence, monument evidence, testimonial evidence or any other material evidence you considered and whether the monument was found or restored through acceptance of an obliterated evidence location.

Dick Berg set an iron pipe at this corner in 1982. Apparently this pipe was plowed out over the years. K. Don Pederson set an iron bar at this corner last year. He matched Berg's distances within 0.3 feet per half mile. He set the bar at the single proportionate position. Berg had done likewise with his pipe. It appears that the bar was set where the pipe had been. I accepted the bar as the corner, placed a red plastic cap on it, and pounded it down 10 inches in the field.


Describe or show any material discrepancy between the location of the restored corner and that of the corner previously restored or reestablished.

NONE KNOWN.

RECORD OF DURABLE WITNESS MONUMENTS


ASSUMED BEARINGS

NO	DESCRIPTION	BEARING	DISTANCE
1	SET A 3/4" x 30" IRON BAR WITH A RED PLASTIC CAP	N 70°12'39" E	203.48 FT.
2	SET A 3/4" x 30" IRON BAR WITH A RED PLASTIC CAP	N 74°42'47" E	183.59 FT.
3	SET A 3/4" x 30" IRON BAR WITH A RED PLASTIC CAP	N 80°16'50" E	165.13 FT.
4	SET A 3/4" x 30" IRON BAR WITH A RED PLASTIC CAP	N 87°11'53" E	148.73 FT.

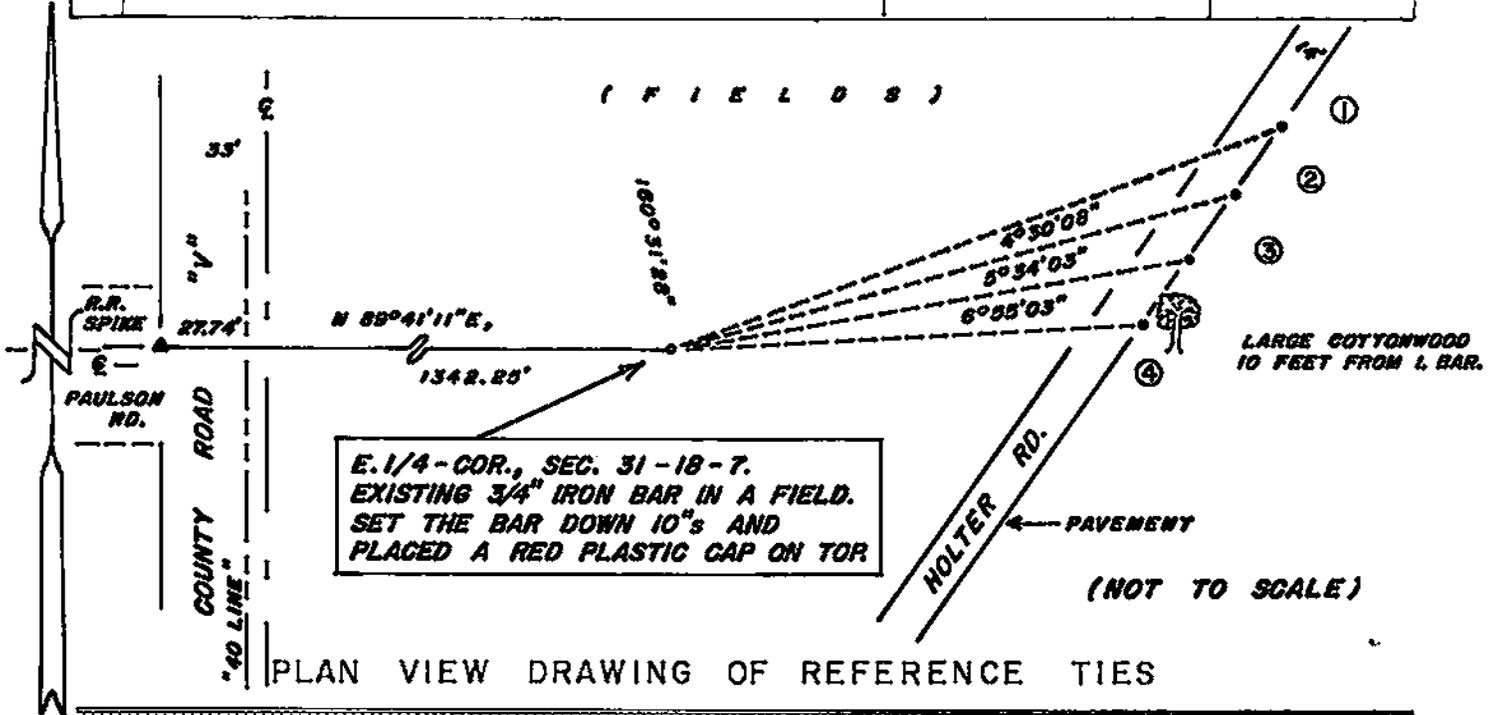


MAP SHOWING DISTANCE AND DIRECTION TO OTHER PUBLIC LAND SURVEY CORNERS USED FOR REESTABLISHING THE CORNER

(K. DON PEDERSON MEASUREMENTS)
(ASSUMED BEARINGS)
(NOT TO SCALE)

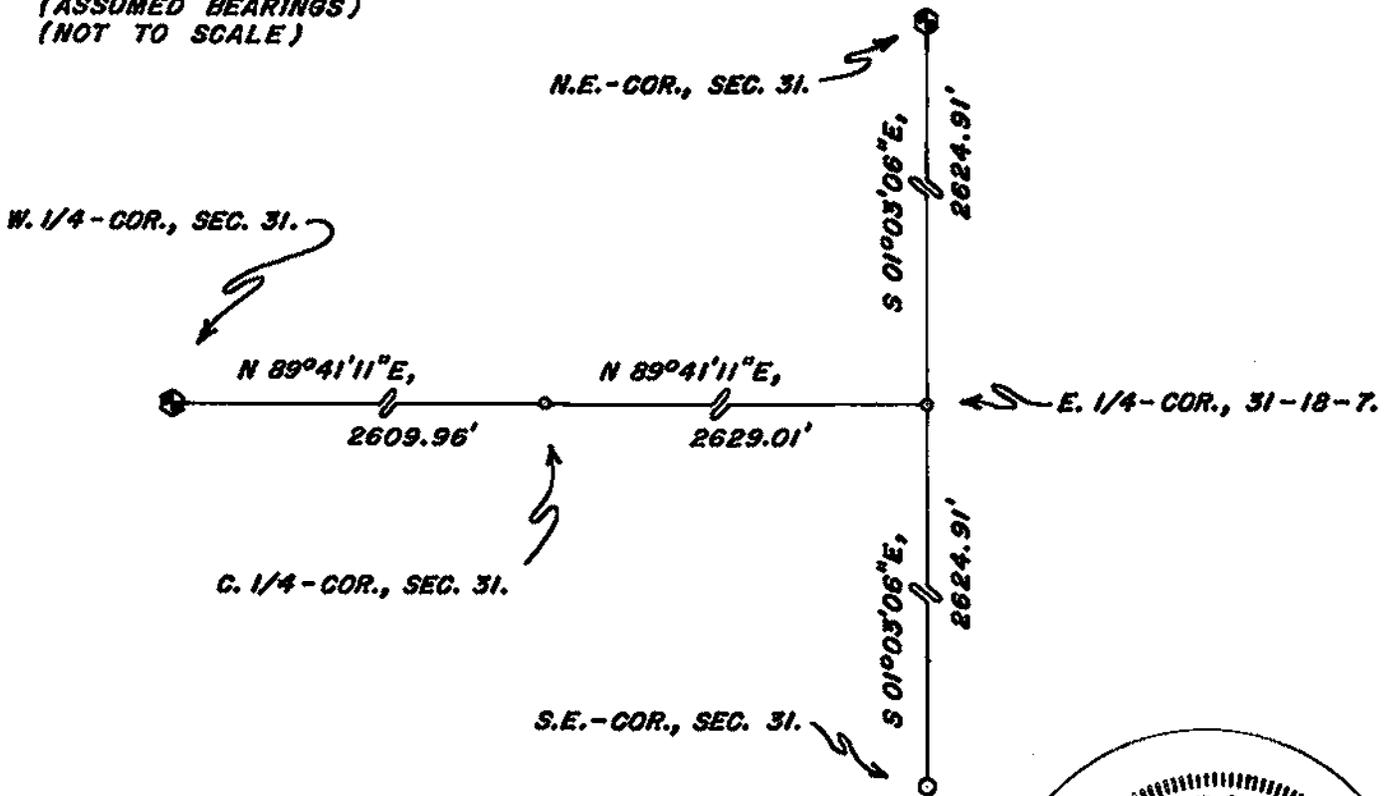

I, WILLIAM C. JUNG, COUNTY SURVEYOR
HEREBY CERTIFY THAT THE CORNER LOCATION SHOWN ON THIS RECORD
WAS DETERMINED BY ME OR UNDER MY DIRECTION AND CONTROL AND
THAT THIS U. S. PUBLIC LAND SURVEY MONUMENT RECORD IS CORRECT
AND COMPLETE TO THE BEST OF MY KNOWLEDGE AND BELIEF.

William C Jung 8/29/07
Signature Date

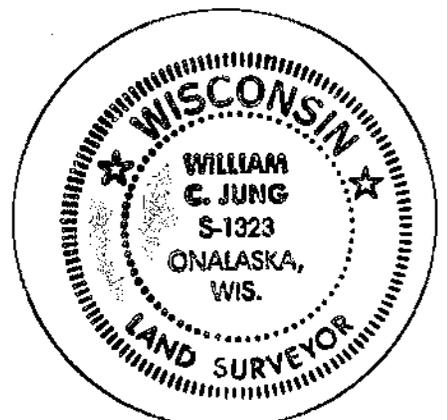

Seal