


21807332000

U. S. PUBLIC LAND SURVEY MONUMENT RECORD

SECTION 33 T 18 N, R 7 W, TOWN OF ONALASKA

LA CROSSE COUNTY

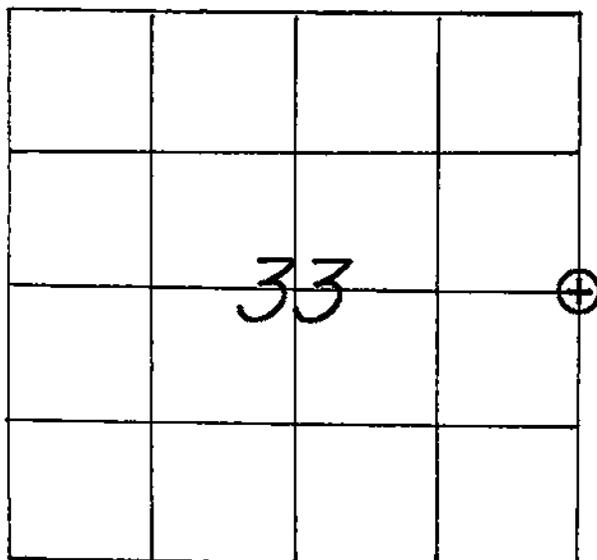

WISCONSIN COORDINATE SYSTEM

North

East

Theta Angle

Horiz. Order

Vert. Order

TYPE OF LANDMARK

3/4" REBAR WITH AN ALUMINUM CAP.

BEARINGS ARE REFERENCED TO

LOCATION OF LANDMARK

CREW: WILLIAM G. JUNG
 PETER F. FOLLANSBEE
 DATE: 11/08/2004

Describe any record evidence, monument evidence, testimonial evidence or any other material evidence you considered and whether the monument was found or restored through acceptance of an obliterated evidence location.

Someone had set an iron bar at this corner at an earlier date. Fechner and Berg had used this corner in 2002. Fechner indicated that the bar was not quite at the "even split" position. That being said, it was set within the allowable error as set by state standards. Thus, since there was no original government corner evidence, I accepted the existing iron bar as the corner.

Describe or show any material discrepancy between the location of the restored corner and that of the corner previously restored or reestablished.

NONE KNOWN.

