


U. S. PUBLIC LAND SURVEY MONUMENT RECORD

SECTION 36 T 18 N, R 7 W, TOWN OF Onalaska
 LA CROSSE COUNTY

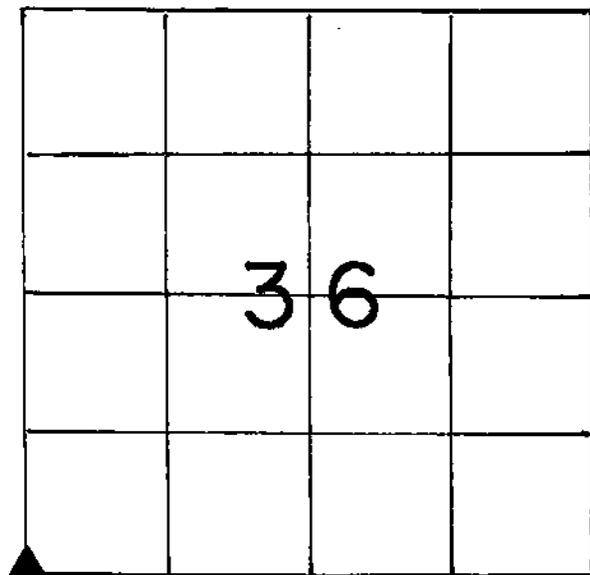

LOCATION OF LANDMARK

Crew: William C. Jung
 Peter Follansbee

Date: 10/28/88

Describe any record evidence, monument evidence, testimonial evidence or any other material evidence you considered and whether the monument was found or restored through acceptance of an obliterated evidence location.

Further North up onto the hill we found straight North-South line fence on the occupied line, (further South the fence bends East). I projected this line fence South and intersected it with the old line fence to the West. I accepted the occupied conditions as the best available evidence of the original government corner position. This location fits very well. I set a railroad spike at the corner as the asphalt is very hard.


Describe or show any material discrepancy between the location of the restored corner and that of the corner previously restored or reestablished.

None known.

WISCONSIN COORDINATE SYSTEM
North
East
Theta Angle
Horiz. Order
Vert. Order
TYPE OF LANDMARK
Railroad Spike
BEARINGS ARE REFERENCED TO
Assumed


RECORD OF DURABLE WITNESS MONUMENTS

NO	DESCRIPTION	BEARING	DISTANCE
1	To the center of a utility box	S8°W ±	112.87
2	To the center of a well pump	-----	95.54
3	Set a 2 1/2" iron pipe 33' West of centerline	West ±	34.82
4	P.K. nail in utility pole	S62°E ±	17.08

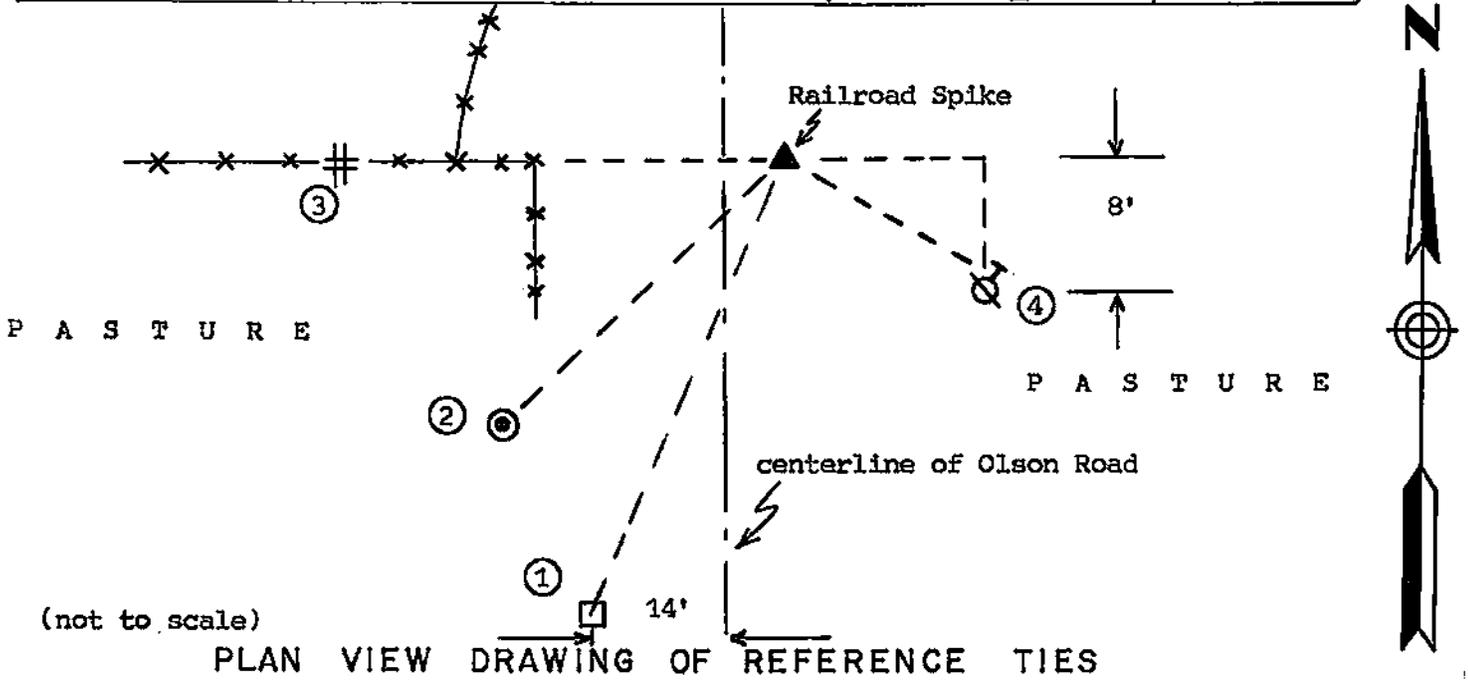

MAP SHOWING DISTANCE AND DIRECTION TO OTHER PUBLIC LAND SURVEY CORNERS USED FOR REESTABLISHING THE CORNER


(not to scale)

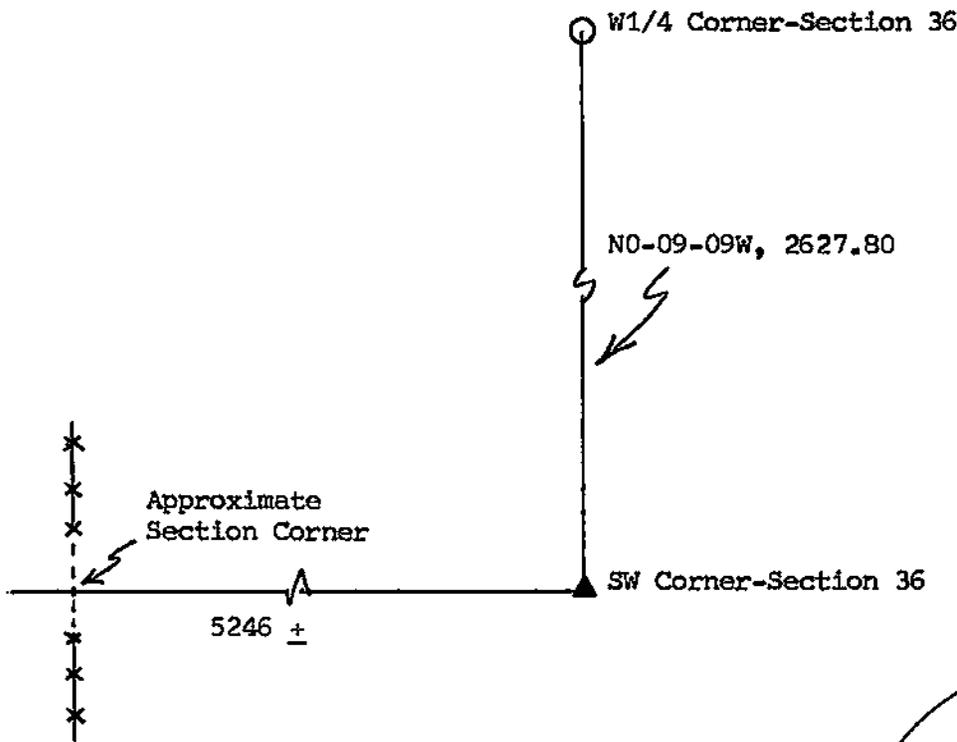

I, William C. Jung, Deputy County Surveyor,
 HEREBY CERTIFY THAT THE CORNER LOCATION SHOWN ON THIS RECORD
 WAS DETERMINED BY ME OR UNDER MY DIRECTION AND CONTROL AND
 THAT THIS U. S. PUBLIC LAND SURVEY MONUMENT RECORD IS CORRECT
 AND COMPLETE TO THE BEST OF MY KNOWLEDGE AND BELIEF.

William C. Jung
 Signature

1/23/89
 Date

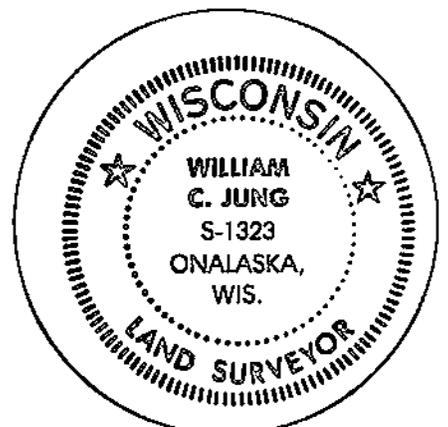

Seal