


21808012000

U. S. PUBLIC LAND SURVEY MONUMENT RECORD

SECTION 6 T 18 N, R 7 W, TOWN OF HOLLAND

LA CROSSE COUNTY

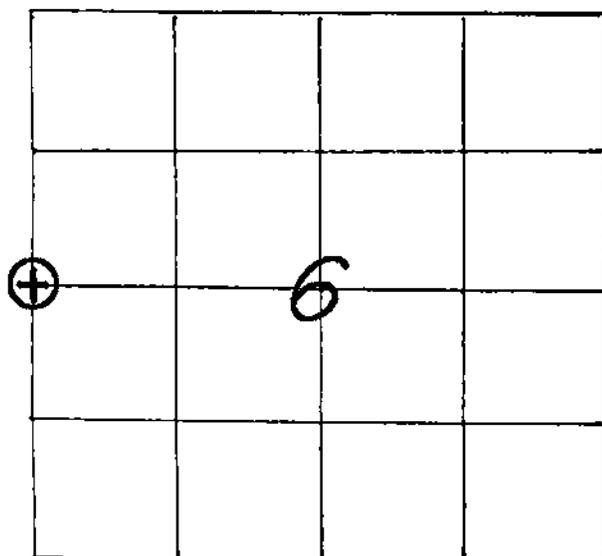

LOCATION OF LANDMARK

CREW: **WILLIAM C. JUNG**
PETER F. FOLLANSBEE
 DATE: **12/28/2006**

WISCONSIN COORDINATE SYSTEM

North **754,730.513**East **1,634,363.595**

Theta Angle

Horiz. Order

Vert. Order

DATUM: 1983('91)

TYPE OF LANDMARK

5/8" x 24" IRON BAR WITH AN ALUMINUM CAP.

BEARINGS ARE REFERENCED TO

GRID NORTH AS PER SECTION DATA.

Describe any record evidence, monument evidence, testimonial evidence or any other material evidence you considered and whether the monument was found or restored through acceptance of an obliterated evidence location.

I found an old railroad tie that had been used as a fence corner where the land-owners had tied off their fence North-South. It fits the single proportionate position so well that I think that it occupies the old government corner location. Thus I accepted this old occupied point as the best location of the original government corner location. I set an iron bar with a cap at the corner. This fits the section line very well.

Describe or show any material discrepancy between the location of the restored corner and that of the corner previously restored or reestablished.

NONE KNOWN.

