


21808122000

U. S. PUBLIC LAND SURVEY MONUMENT RECORD

SECTION 7 T 18 N, R 7 W, TOWN OF HOLLAND

LA CROSSE COUNTY

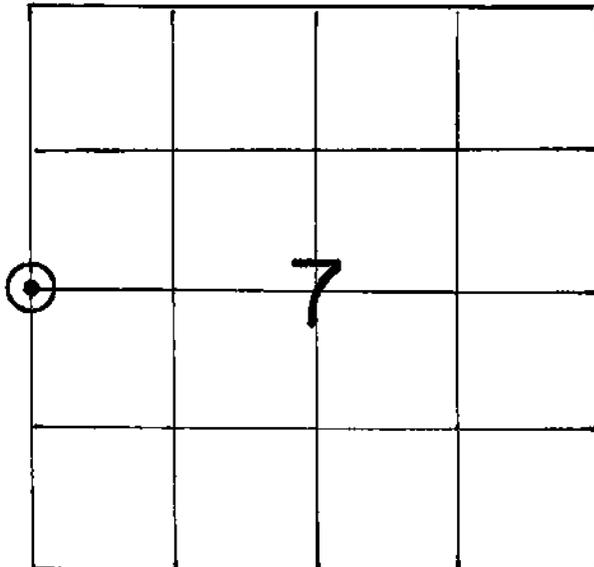

LOCATION OF LANDMARK

WISCONSIN COORDINATE SYSTEM

North

East

Theta Angle

Horiz. Order

Vert. Order

TYPE OF LANDMARK

Set P.K. Nail in centerline of road.

BEARINGS ARE REFERENCED TO

Assumed

Crew: WILLIAM C. JUNG
PETER F. FOLLANSBEE

Date: 7/09/1992 and 10/25/89 and 5/19/92 and 6/13/05 and 10/17/05

Describe any record evidence, monument evidence, testimonial evidence or any other material evidence you considered and whether the monument was found or restored through acceptance of an obliterated evidence location.

There was a P.K. nail at this corner that had been used in several surveys. Dick Berg replaced this P.K. with a railroad spike. This spike was paved over. I set a P.K. nail in the asphalt over the railroad spike. This location was again used as the corner in more surveys.

2005- The P.K. nail and railroad spike were knocked out due to road repaving.

We set a new P.K. nail and cap at the corner.

Describe or show any material discrepancy between the location of the restored corner and that of the corner previously restored or reestablished.


None Known.

- ⑤ Set a 3/4"x30" iron bar with red plastic cap on the South side of the parking pavement 4.8 feet West of the Southeast cor. of the

RECORD OF DURABLE WITNESS MONUMENTS


4.8 feet West of the Southeast cor.

NO	DESCRIPTION	BEARING	DISTANCE
1	Existing P.K. Nail in edge of pavement	Southwesterly_±	38.83 Ft.
2	Set Rebar	Northwesterly _±	44.96 Ft.
3	Center of street sign post at the base	Northeasterly _±	45.03 Ft.
4	Set 1" Iron Pipe near fence	Southeasterly _±	70.02 Ft.

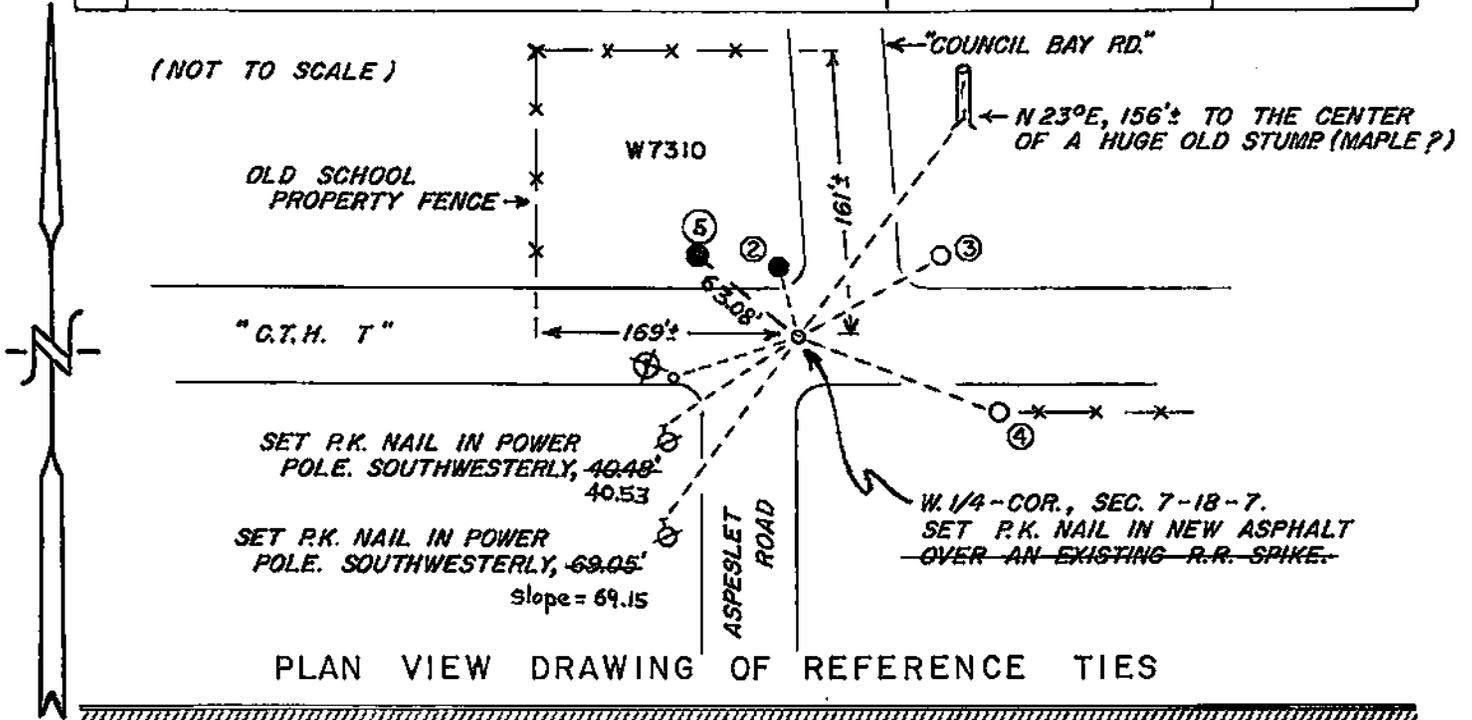

MAP SHOWING DISTANCE AND DIRECTION TO OTHER PUBLIC LAND SURVEY CORNERS USED FOR REESTABLISHING THE CORNER

(not to scale)

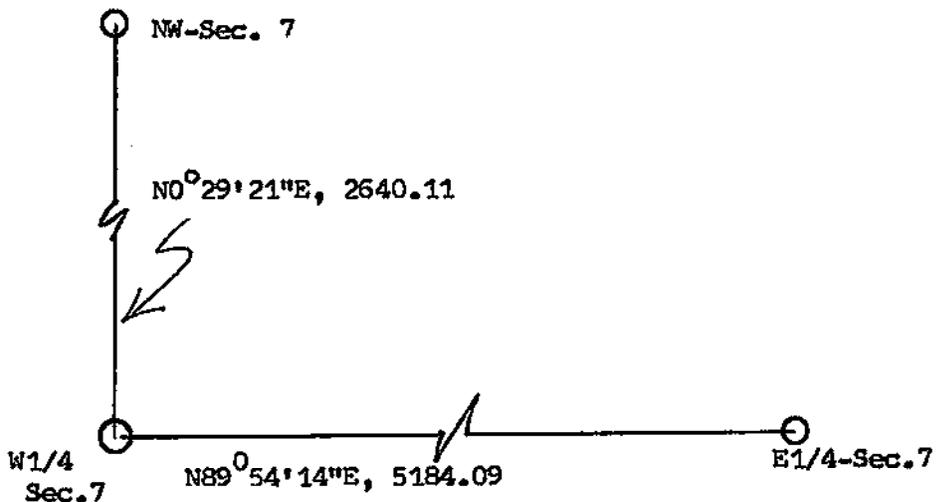


I, William C. Jung, County Surveyor
 HEREBY CERTIFY THAT THE CORNER LOCATION SHOWN ON THIS RECORD WAS DETERMINED BY ME OR UNDER MY DIRECTION AND CONTROL AND THAT THIS U. S. PUBLIC LAND SURVEY MONUMENT RECORD IS CORRECT AND COMPLETE TO THE BEST OF MY KNOWLEDGE AND BELIEF.

William C. Jung
 Signature

April 27, 1994
 Date

Revised: 12/2/05 *W.C.J.*

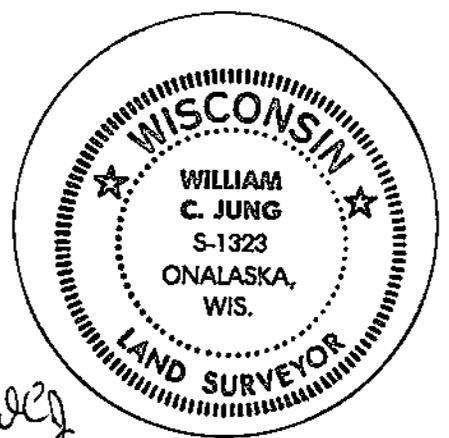

Seal