


U. S. PUBLIC LAND SURVEY MONUMENT RECORD

SECTION 30 T 18 N, R 7 W, TOWN OF HOLLAND
 LA CROSSE COUNTY

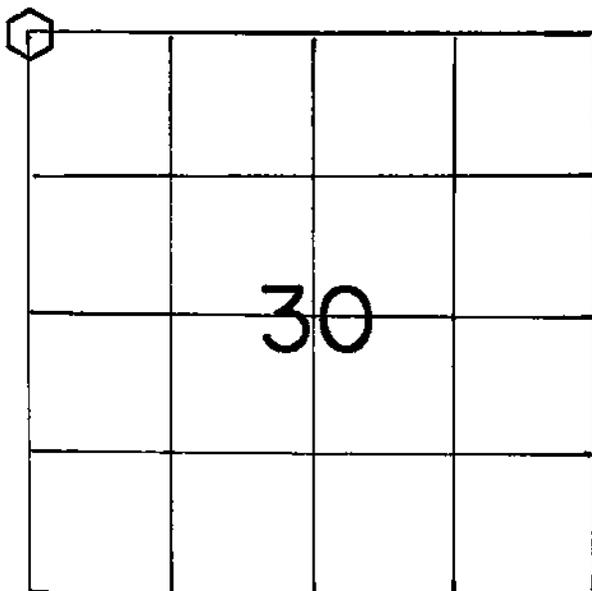

LOCATION OF LANDMARK

Crew: WILLIAM C. JUNG
 PETER F. FOLLANSBEE
 Date: 4/06/1995

Describe any record evidence, monument evidence, testimonial evidence or any other material evidence you considered and whether the monument was found or restored through acceptance of an obliterated evidence location.

I found an iron pipe at the corner which had been used in previous survey work. I've accepted this pipe as the best available evidence of the original corner position, removed it, and replaced it with a brass capped Lunde marker.

Describe or show any material discrepancy between the location of the restored corner and that of the corner previously restored or reestablished.

None Known.

WISCONSIN COORDINATE SYSTEM
North
East
Theta Angle
Horiz. Order
Vert. Order
TYPE OF LANDMARK
Brass cap Lunde marker.
BEARINGS ARE REFERENCED TO
True North.

RECORD OF DURABLE WITNESS MONUMENTS


MAGNETIC

NO	DESCRIPTION	BEARING	DISTANCE
1	Ex. 1/2" Steel Pin in 18" Oak	N 29° W	26.19 Ft.
2	Set P.K. Nail in NW-side 6" Aspen	S 25° W	9.43 Ft.
3	Ex. Spike in SW-side 5 1/2" Aspen	N 33° E	2.18 Ft.
4	Ex. Spike in NW-side 7" Aspen	S 42° E	14.52 Ft.

(Note: all Bearing Trees are single blazed.)

(Scale: 1" = 15')


NW-Cor., Sec. 30-18-7.
 Set brass cap Lunde marker to replace an existing 1 1/2" iron pipe. Buried a Wine bottle with the marker and set a sign & post on the north side. Downed fence wire 17.5' north of the corner.

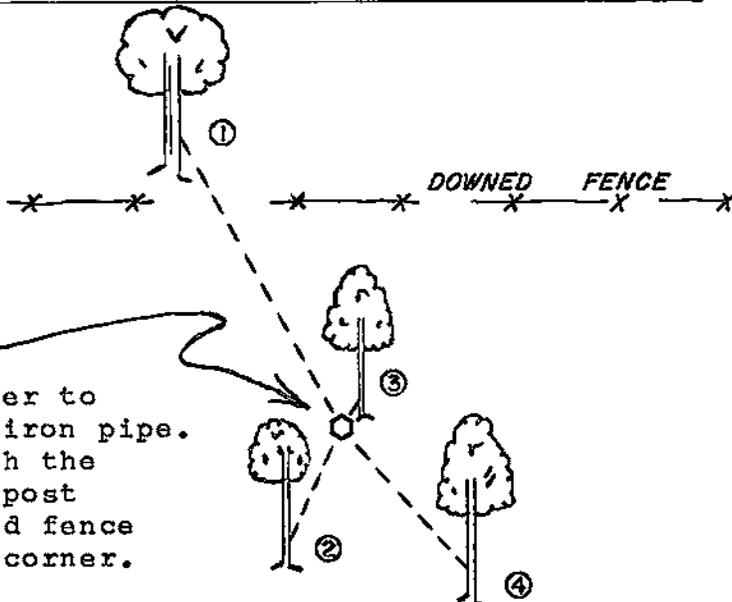

PLAN VIEW DRAWING OF REFERENCE TIES


MAP SHOWING DISTANCE AND DIRECTION TO OTHER PUBLIC LAND SURVEY CORNERS USED FOR REESTABLISHING THE CORNER

(not to scale)

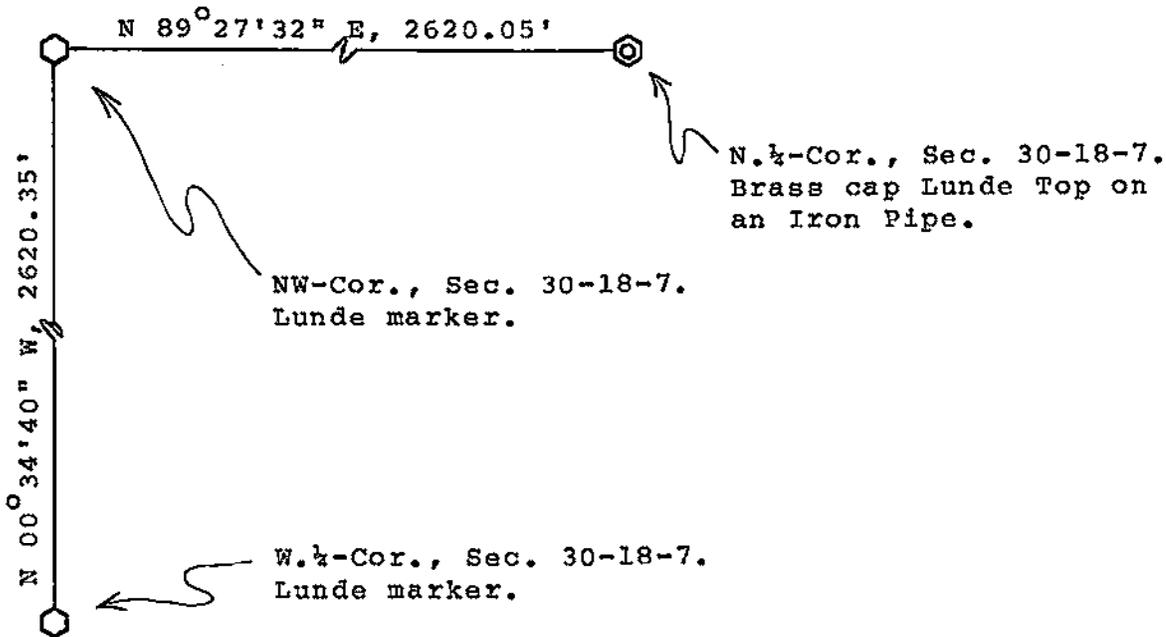

I, William C. Jung, County Surveyor
 HEREBY CERTIFY THAT THE CORNER LOCATION SHOWN ON THIS RECORD WAS DETERMINED BY ME OR UNDER MY DIRECTION AND CONTROL AND THAT THIS U. S. PUBLIC LAND SURVEY MONUMENT RECORD IS CORRECT AND COMPLETE TO THE BEST OF MY KNOWLEDGE AND BELIEF.

William C. Jung 7/7/95
 Signature Date

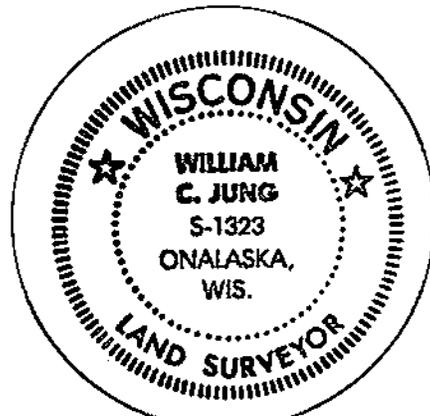

Seal