


U. S. PUBLIC LAND SURVEY MONUMENT RECORD

SECTION 30 T 18 N, R 7 W, TOWN OF HOLLAND

LA CROSSE COUNTY

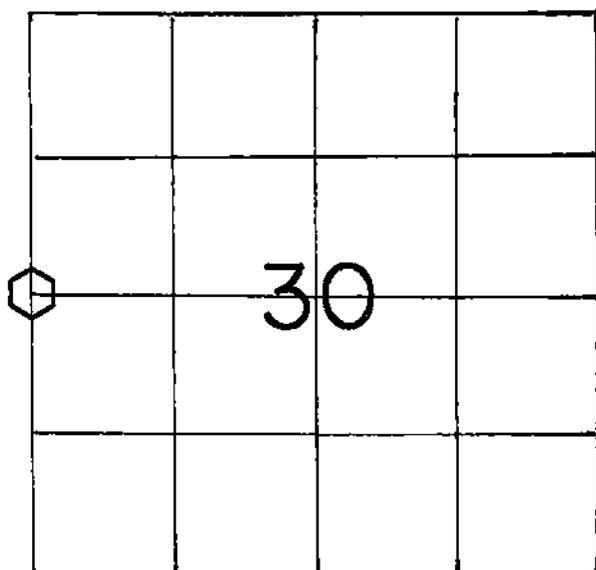

LOCATION OF LANDMARK

WISCONSIN COORDINATE SYSTEM

North

East

Theta Angle

Horiz. Order

Vert. Order

TYPE OF LANDMARK

Brass cap Lunde marker.

BEARINGS ARE REFERENCED TO

True North.

Crew: WILLIAM C. JUNG
 PETER F. FOLLANSBEE
 Date: 6/05/1995

Describe any record evidence, monument evidence, testimonial evidence or any other material evidence you considered and whether the monument was found or restored through acceptance of an obliterated evidence location.

I set the corner in the old East-West fence and on line with the section corners. The corner was monumented with a brass capped Lunde marker. At 3' to 5' East of the corner there was old evidence of the fence being tied off East and West.

Describe or show any material discrepancy between the location of the restored corner and that of the corner previously restored or reestablished.


None Known.

RECORD OF DURABLE WITNESS MONUMENTS

NO	DESCRIPTION	MAGNETIC	
		BEARING	DISTANCE
1	Set P.K. Nail in SW-side 17" Hickory	N 27° W	21.42 Ft.
2	Set P.K. Nail in SE-side 15" Aspen	N 31° E	Sl.=62.00'
3	Set P.K. Nail in SW-side 11" White Oak	S 52° E	Sl.=57.50'
4	Set P.K. Nail in SE-side 6½" White Oak	S 38° W	39.32 Ft.


W.¼-Cor., Sec. 30-18-7.
 Set brass cap Lunde marker under fence. Buried a Wine bottle containing a shell casing with the marker and set a sign & post on the north side.

(Note: all Bearing Trees are double blazed.)

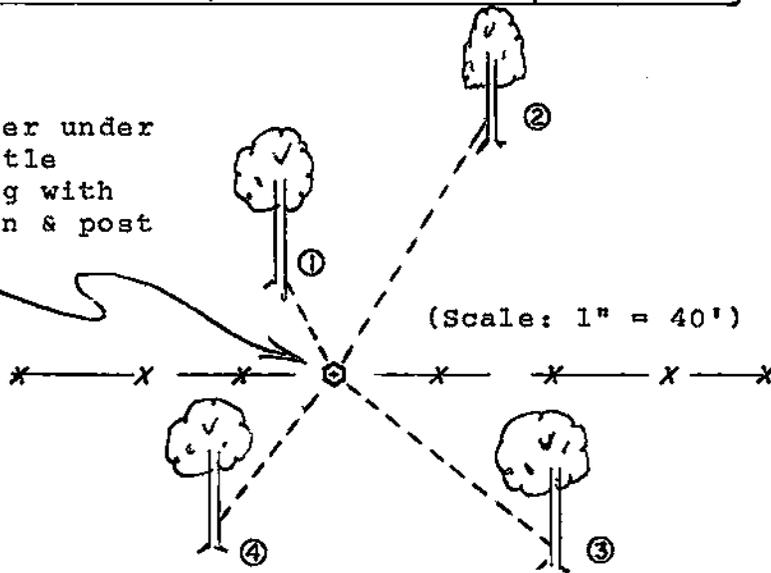

(WOODS)
 PLAN VIEW DRAWING OF REFERENCE TIES

MAP SHOWING DISTANCE AND DIRECTION TO OTHER PUBLIC LAND SURVEY CORNERS USED FOR REESTABLISHING THE CORNER (not to scale)

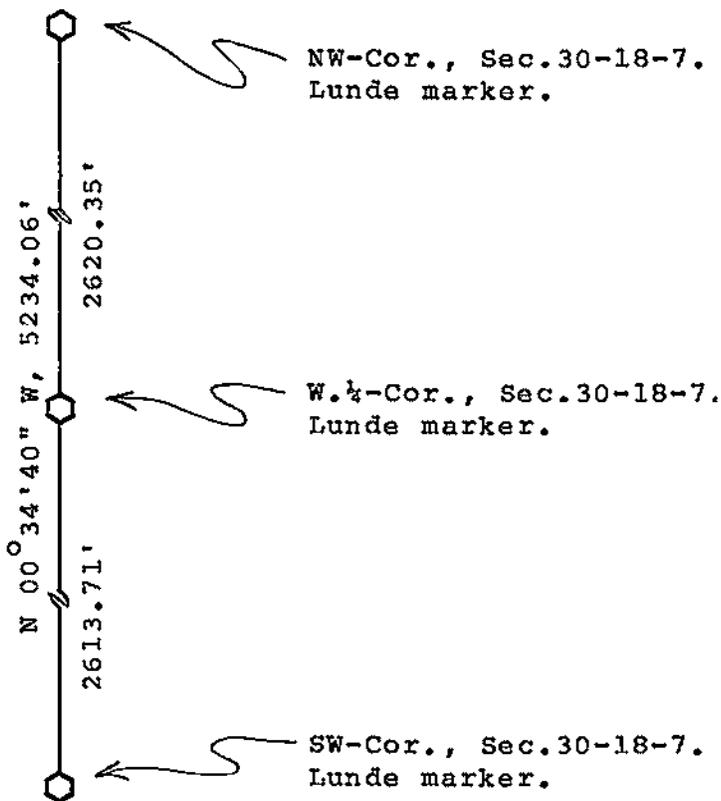

I, William C. Jung, County Surveyor
 HEREBY CERTIFY THAT THE CORNER LOCATION SHOWN ON THIS RECORD WAS DETERMINED BY ME OR UNDER MY DIRECTION AND CONTROL AND THAT THIS U. S. PUBLIC LAND SURVEY MONUMENT RECORD IS CORRECT AND COMPLETE TO THE BEST OF MY KNOWLEDGE AND BELIEF.

William C. Jung
 Signature

7/7/95
 Date



Seal