


U. S. PUBLIC LAND SURVEY MONUMENT RECORD

SECTION 2 T 18 N, R 7 W, TOWN OF Farmington

LA CROSSE COUNTY

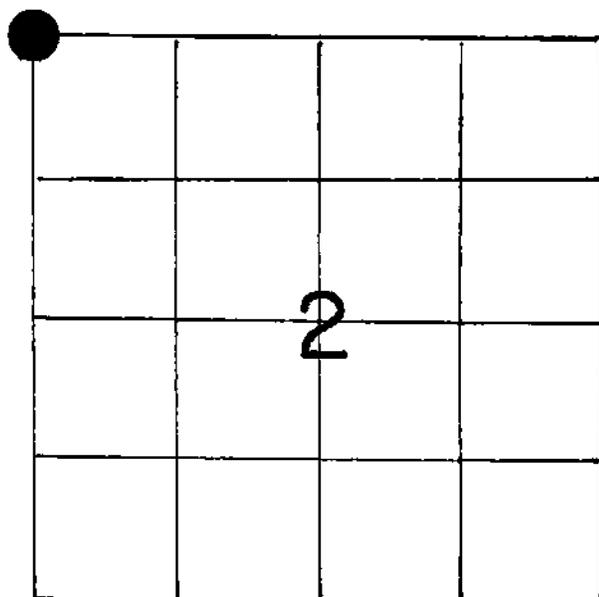

LOCATION OF LANDMARK

WISCONSIN COORDINATE SYSTEM	
North	757,088.368
East	1,655,225.639
Theta Angle	
Horiz. Order	
Vert. Order	
DATUM:	1983('91)
TYPE OF LANDMARK	
Set brass cap Lunde marker	
BEARINGS ARE REFERENCED TO	

Crew: WILLIAM C. JUNG

Date: 9/18/1991

Describe any record evidence, monument evidence, testimonial evidence or any other material evidence you considered and whether the monument was found or restored through acceptance of an obliterated evidence location.


As Hurlburt did, I accepted an existing drift pin as the best available evidence of the original government corner position. I replaced the drift pin with a brass capped Lunde marker. A post with sign was set to the NW, and a whiskey bottle with a shell casing was buried near the Lunde.

Describe or show any material discrepancy between the location of the restored corner and that of the corner previously restored or reestablished.

None known

RECORD OF DURABLE WITNESS MONUMENTS

NO	DESCRIPTION	MAGNETIC	
		BEARING	DISTANCE
1	Set Nail in NW-side 2' Oak(unblazed)	N 08 E	112.8 Ft.
2	Set 1 1/4" iron pipe with elbow	East	14.01 Ft.
3	Set P.K. Nail in SW-side 4" Norway(unblazed)	S 45 E	28 Ft.
4	Set P.K. Nail in W-side 4" Norway(unblazed)	S 07 E	28.5 Ft.

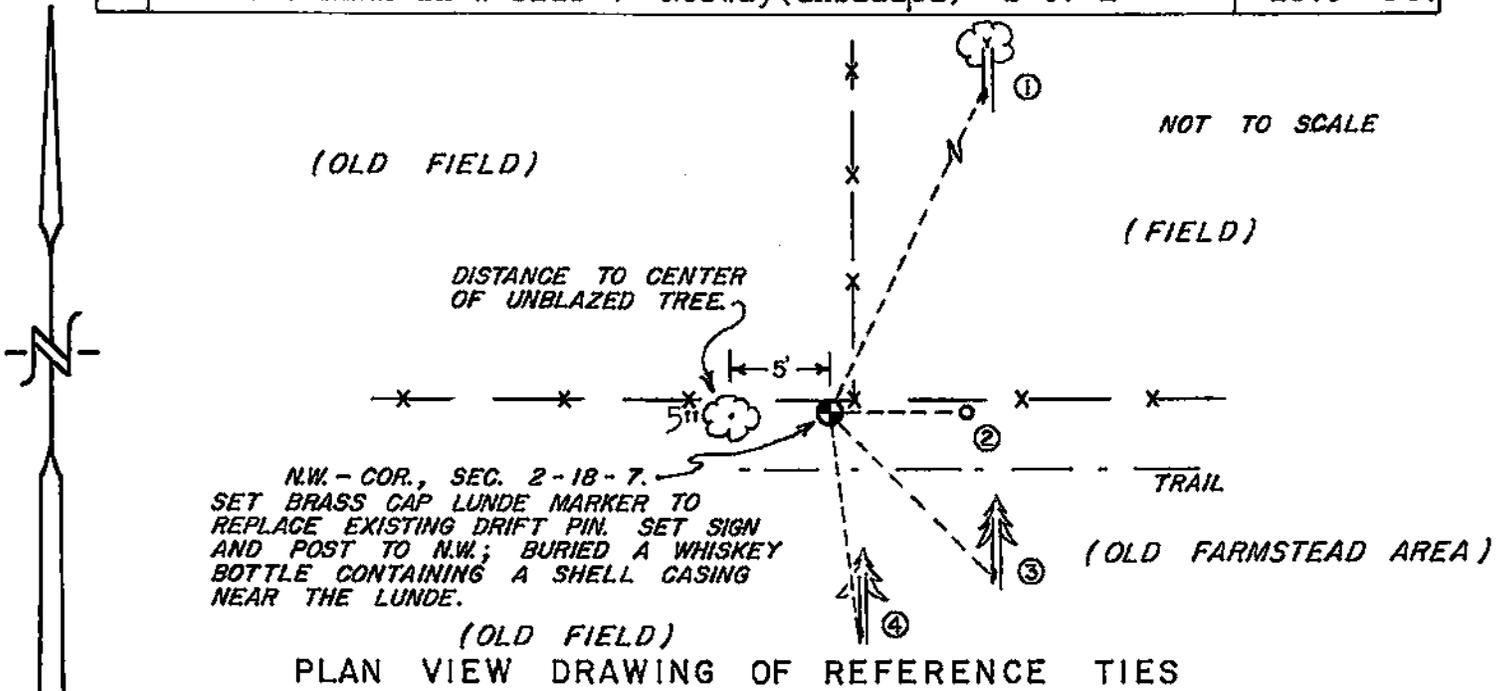

MAP SHOWING DISTANCE AND DIRECTION TO OTHER PUBLIC LAND SURVEY CORNERS USED FOR REESTABLISHING THE CORNER

No section measurements were made by me at this time. See section data of record.

I, William C. Jung, Deputy County Surveyor
 HEREBY CERTIFY THAT THE CORNER LOCATION SHOWN ON THIS RECORD
 WAS DETERMINED BY ME OR UNDER MY DIRECTION AND CONTROL AND
 THAT THIS U. S. PUBLIC LAND SURVEY MONUMENT RECORD IS CORRECT
 AND COMPLETE TO THE BEST OF MY KNOWLEDGE AND BELIEF.

William C. Jung
 Signature

November 8, 1991
 Date



Seal