


U. S. PUBLIC LAND SURVEY MONUMENT RECORD

SECTION 2 T 18 N, R 7 W, TOWN OF Farmington

LA CROSSE COUNTY

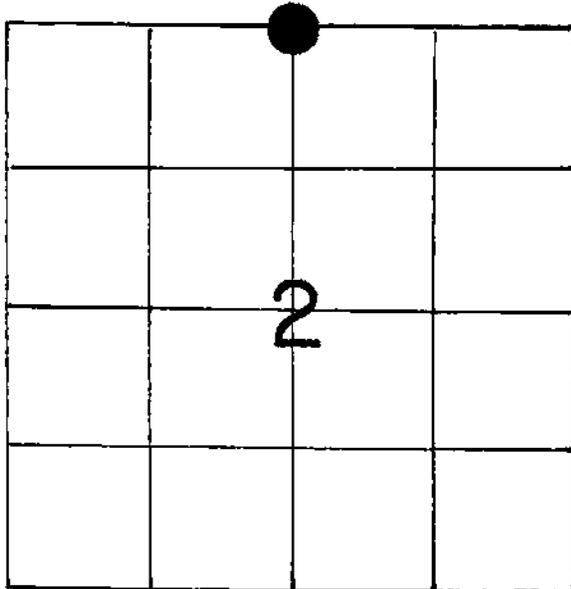

LOCATION OF LANDMARK

WISCONSIN COORDINATE SYSTEM	
North	757,024.277
East	1,657,879.769
Theta Angle	
Horiz. Order	
Vert. Order	
DATUM:	1983('91)
TYPE OF LANDMARK	
Set brass cap Lunde marker	
BEARINGS ARE REFERENCED TO	

Crew: WILLIAM C. JUNG

Date: 9/19/1991

Describe any record evidence, monument evidence, testimonial evidence or any other material evidence you considered and whether the monument was found or restored through acceptance of an obliterated evidence location.

As Hurlburt did, I accepted the occupied fence corner as the best available evidence of the original government corner position. I set a brass capped Lunde marker near the NW corner of the corner post. A whiskey bottle with a shell casing was buried to the South of the Lunde.

Describe or show any material discrepancy between the location of the restored corner and that of the corner previously restored or reestablished.

None known

