


21808010020

U. S. PUBLIC LAND SURVEY MONUMENT RECORD

SECTION 12 T 18 N, R 8 W, TOWN OF HOLLAND
 LA CROSSE COUNTY

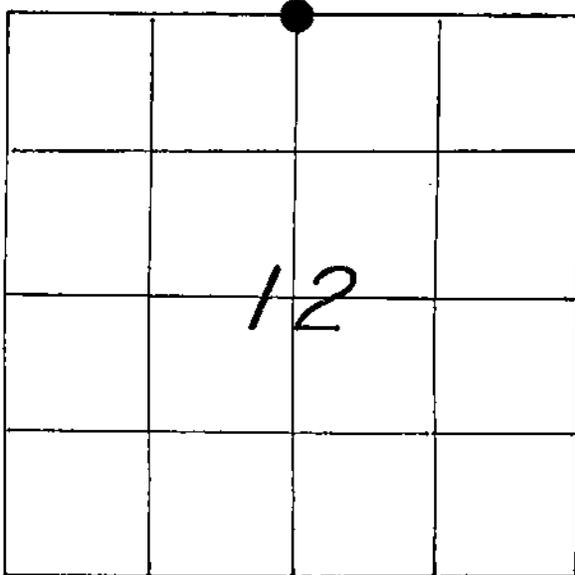

WISCONSIN COORDINATE SYSTEM

North

East

Theta Angle

Horiz. Order

Vert. Order

TYPE OF LANDMARK

3/4" x 30" ROUND IRON BAR

BEARINGS ARE REFERENCED TO

LOCATION OF LANDMARK

CREW: *WILLIAM C. JUNG*
PETER F. FOLLANSBEE
 DATE: *4/30/1999*

Describe any record evidence, monument evidence, testimonial evidence or any other material evidence you considered and whether the monument was found or restored through acceptance of an obliterated evidence location.


I found a P.K. nail at the occupied corner. This point had been used in previous survey work. I accepted it as the best available evidence of the original government corner position. The P.K. was replaced with an iron bar.

Describe or show any material discrepancy between the location of the restored corner and that of the corner previously restored or reestablished.

NONE KNOWN.

RECORD OF DURABLE WITNESS MONUMENTS
MAGNETIC


NO	DESCRIPTION	BEARING	DISTANCE
1	SET A P.K. NAIL IN S.W.-SIDE UNBLAZED 12" NORWAY	N 40° W	80.61 FT.
2	SET A P.K. NAIL IN S.W.-SIDE UNBLAZED 10" NORWAY	N 22° W	65.89 FT.
3	SET A "T" BAR DOWN 3 INCHES	N 49° E	71.56 FT.
4	SET A 3/4" x 30" ROUND IRON BAR ON W-SIDE OLD POST	SOUTH ±	25.15 FT.

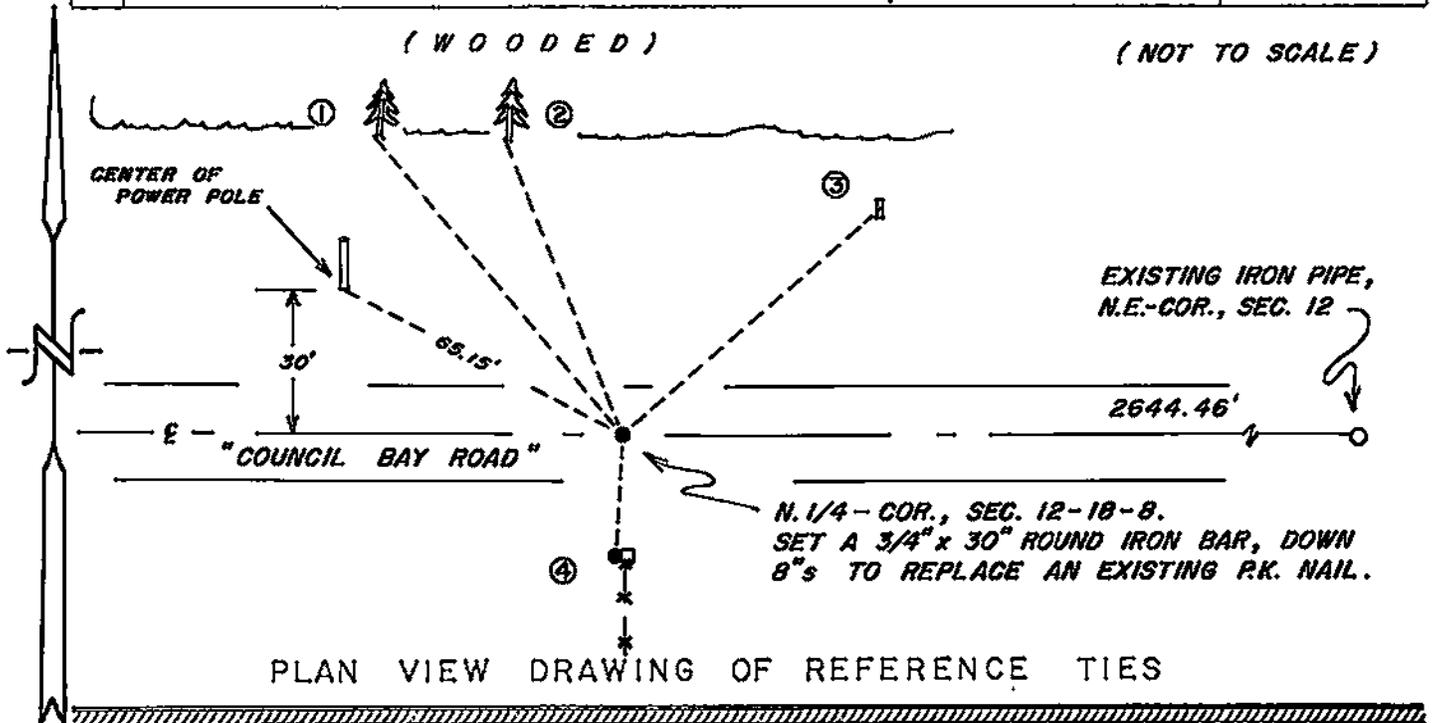

MAP SHOWING DISTANCE AND DIRECTION TO OTHER PUBLIC LAND SURVEY CORNERS USED FOR REESTABLISHING THE CORNER


(J. NELSEN MEASUREMENTS)

(not to scale)

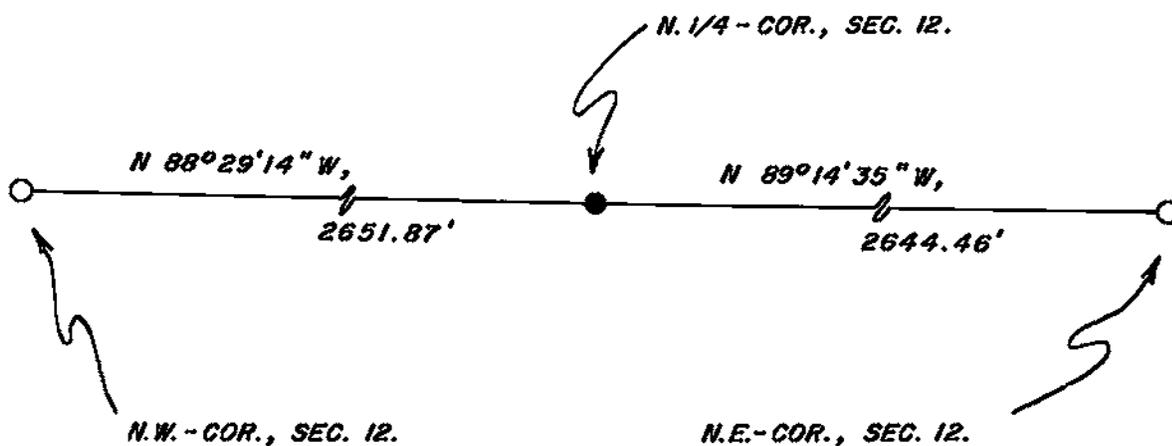

I, WILLIAM G. JUNG, COUNTY SURVEYOR
HEREBY CERTIFY THAT THE CORNER LOCATION SHOWN ON THIS RECORD WAS DETERMINED BY ME OR UNDER MY DIRECTION AND CONTROL AND THAT THIS U. S. PUBLIC LAND SURVEY MONUMENT RECORD IS CORRECT AND COMPLETE TO THE BEST OF MY KNOWLEDGE AND BELIEF.

William G. Jung 5/13/99
Signature Date

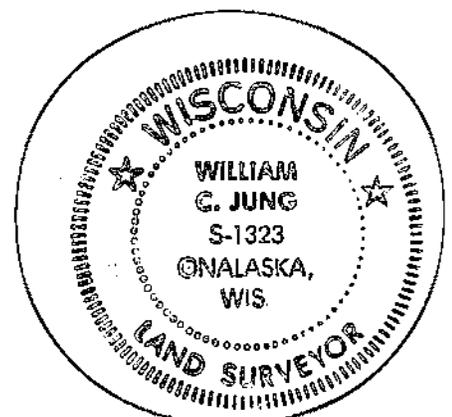

Seal