


U. S. PUBLIC LAND SURVEY MONUMENT RECORD

SECTION 12 T 18 N, R 8 W, TOWN OF HOLLAND
LA CROSSE COUNTY

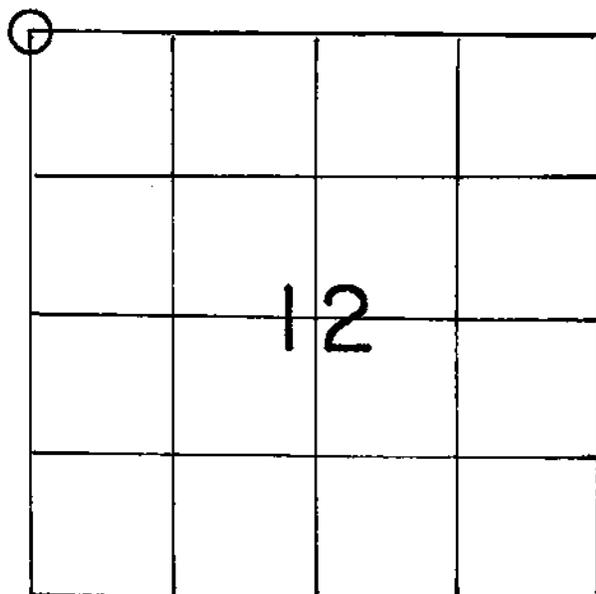

LOCATION OF LANDMARK

D.O.T. values - 1927 Datum

WISCONSIN COORDINATE SYSTEM

North 752,283.080

East 1,660,559.526

Theta Angle

Horiz. Order

Vert. Order

TYPE OF LANDMARK

Existing 1-3/4" Iron Pipe (O.D.)

BEARINGS ARE REFERENCED TO

Terry L. Kerwin's survey dated
5/28/90 located in the NW $\frac{1}{4}$ -NW $\frac{1}{4}$,
Section 13-18-8.

Crew: WILLIAM C. JUNG
PETER F. FOLLANSBEE

Date: 9/09/1993

Describe any record evidence, monument evidence, testimonial evidence or any other material evidence you considered and whether the monument was found or restored through acceptance of an obliterated evidence location.

I found an iron pipe at the corner which had been used in previous survey work as the section corner. I accepted this pipe as the best available evidence of the original government corner position.

Describe or show any material discrepancy between the location of the restored corner and that of the corner previously restored or reestablished.


None Known

RECORD OF DURABLE WITNESS MONUMENTS

NO	DESCRIPTION	BEARING	DISTANCE
1	Ex. Berntsen D.O.T. Ref. Marker #2 (3.1' S. fence)	S 88°53'00.3" W	187.295'
2	Set P.K. Nail in S.-side 17" Cottonwood(unblazed)	N 89° W (Mag.)	114.01'
3	Set P.K. Nail in SW-side 13" triple Birch(unblazed)	N 74° W (Mag.)	78.32'
4	Exist. D.O.T. Aluminum Cap Ref. Marker #4	N 88°54'14.5" E	142.175'

(NOTE: TREES ARE UNBLAZED)


(NOT TO SCALE)

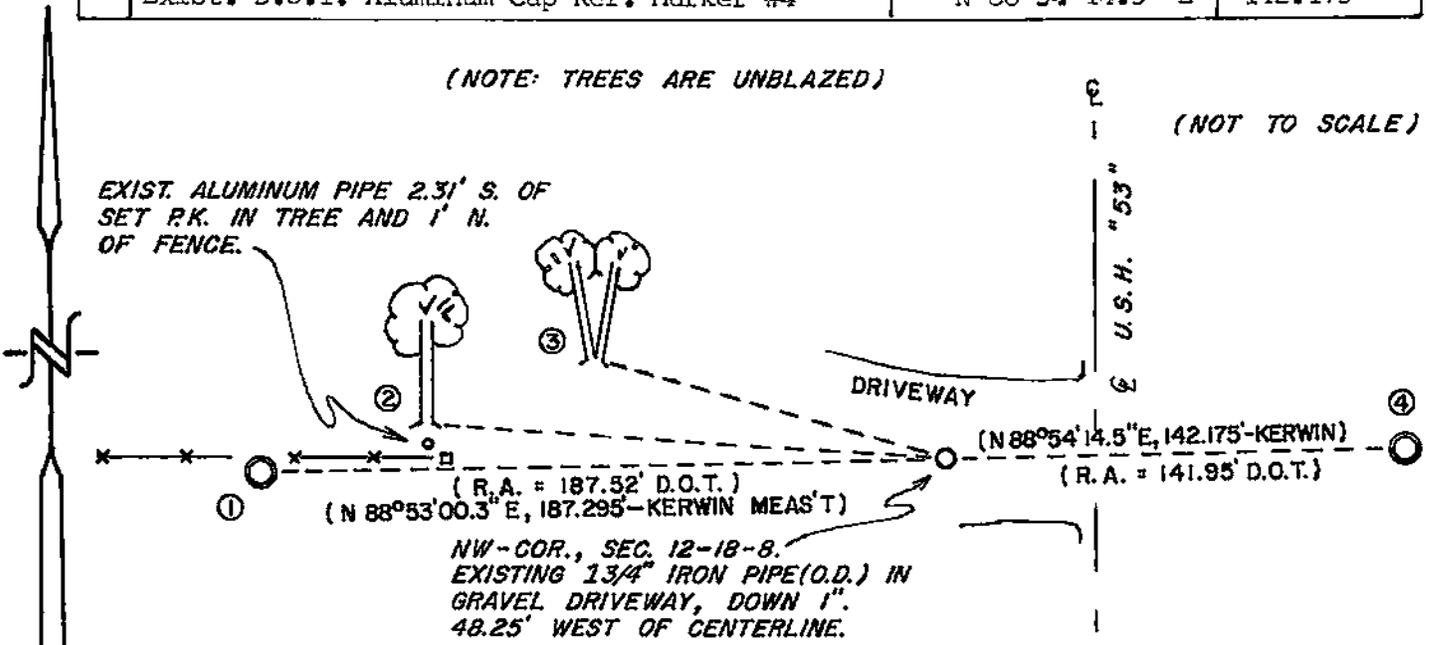

PLAN VIEW DRAWING OF REFERENCE TIES


MAP SHOWING DISTANCE AND DIRECTION TO OTHER PUBLIC LAND SURVEY CORNERS USED FOR REESTABLISHING THE CORNER

(not to scale)

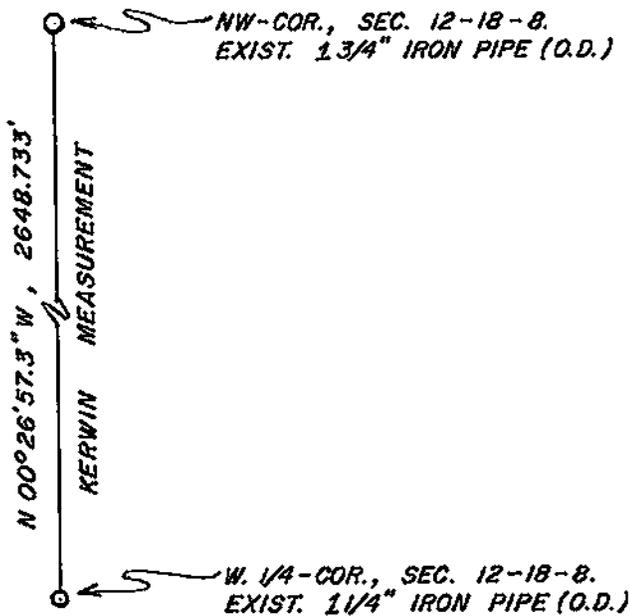

I, William C. Jung, County Surveyor
 HEREBY CERTIFY THAT THE CORNER LOCATION SHOWN ON THIS RECORD WAS DETERMINED BY ME OR UNDER MY DIRECTION AND CONTROL AND THAT THIS U. S. PUBLIC LAND SURVEY MONUMENT RECORD IS CORRECT AND COMPLETE TO THE BEST OF MY KNOWLEDGE AND BELIEF.

William C. Jung 12/29/93
 Signature Date

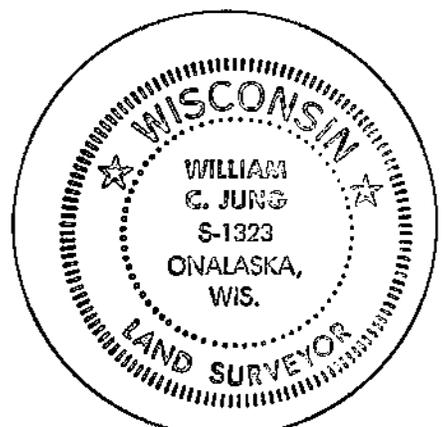

Seal