

21808022000

TREMPEALEAU COUNTY


U.S. PUBLIC LAND SURVEY MONUMENT RECORD

QUARTER Corner common to Sections 1 8 2

T. 18 N., R. 8 W.

Type of monument 7/8" X30" REBAR WITH ALUMINUM CAP

Location indicated on sketch -  -

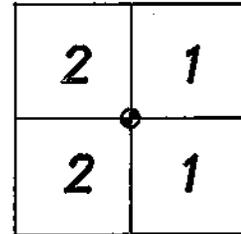

Location Sketch

Describe any record evidence, monument evidence, occupational evidence, testimonial evidence or any other material evidence you considered, and whether the monument was found or placed.

ORIGINAL GOVERNMENT ACCESSORIES WERE SEARCHED FOR, BUT NOTHING WAS FOUND. OTHER MONUMENT EVIDENCE WAS SEARCHED FOR, BUT NONE WAS FOUND. MISCELLANEOUS SURVEY NOTES, ON FILE AT THE COUNTY SURVEYOR'S OFFICE INDICATE TWO POSITIONS FOR THIS CORNER. APPARENTLY THIS CORNER WAS INTENDED TO BE REESTABLISHED BY SINGLE PROPORTIONATE MEASUREMENT BETWEEN THE NORTHEAST AND SOUTHEAST CORNERS OF SECTION 2-18-8. IT APPEARS THAT IN THE LATE 1970S OR EARLY 1980S A P.K. NAIL WAS SET AT SAID SINGLE PROPORTION POSITION, MONUMENTING THE FIRST POSITION. IT APPARENTLY WAS DISCOVERED AT A LATER DATE THAT THE NORTHEAST CORNER OF SECTION 2-18-8 WAS INCORRECTLY DETERMINED. THIS QUARTER CORNER WAS APPARENTLY REESTABLISHED, AGAIN AT SINGLE PROPORTION, THEREBY CREATING THE SECOND POSITION. IT APPEARS THAT T. KERWIN, R. CONNELL AND D. KROHN SURVEYS USED THE SECOND POSITION, WHILE S. SOLBERG AND DEPARTMENT OF TRANSPORTATION SURVEYS USED THE FIRST. NEITHER MONUMENTS WERE FOUND AND APPEAR TO HAVE BEEN LOST TO ROAD CONSTRUCTION. THIS 1999 SURVEY REESTABLISHES THIS POSITION BY SINGLE PROPORTIONATE MEASUREMENT BETWEEN THE CORRECTED NORTHEAST CORNER OF SECTION 2-18-8 AND THE SOUTHEAST CORNER OF SECTION 2-18-8. THIS MATCHES VERY WELL WITH MEASUREMENT DATA AS SHOWN ON SURVEYS AND NOTES OF RECORD. THEREFORE, BELIEVING THE SINGLE PROPORTIONATE MEASUREMENT POSITION, AS DESCRIBED, TO BE THE BEST AVAILABLE EVIDENCE OF THIS CORNER'S ORIGINAL LOCATION, A 7/8" X30" REBAR WITH AN ALUMINUM CAP WAS SET AND REFERENCED AS SHOWN BELOW.

Show a plan view drawing depicting the relevant monuments, providing reference ties to at least 4 witness monuments. Describe witness monuments. Show relationship to occupation.

o SET 5/8" X24" REBAR WITH PLASTIC CAP


BEARINGS REFERENCED TO THE TREMPLEALEAU COUNTY COORDINATE SYSTEM

FOUND 4" D.O.T ALUM. MON. AT TOP OF SLOPE



no scale

SURVEY SIGN POST 1' EAST OF MON.

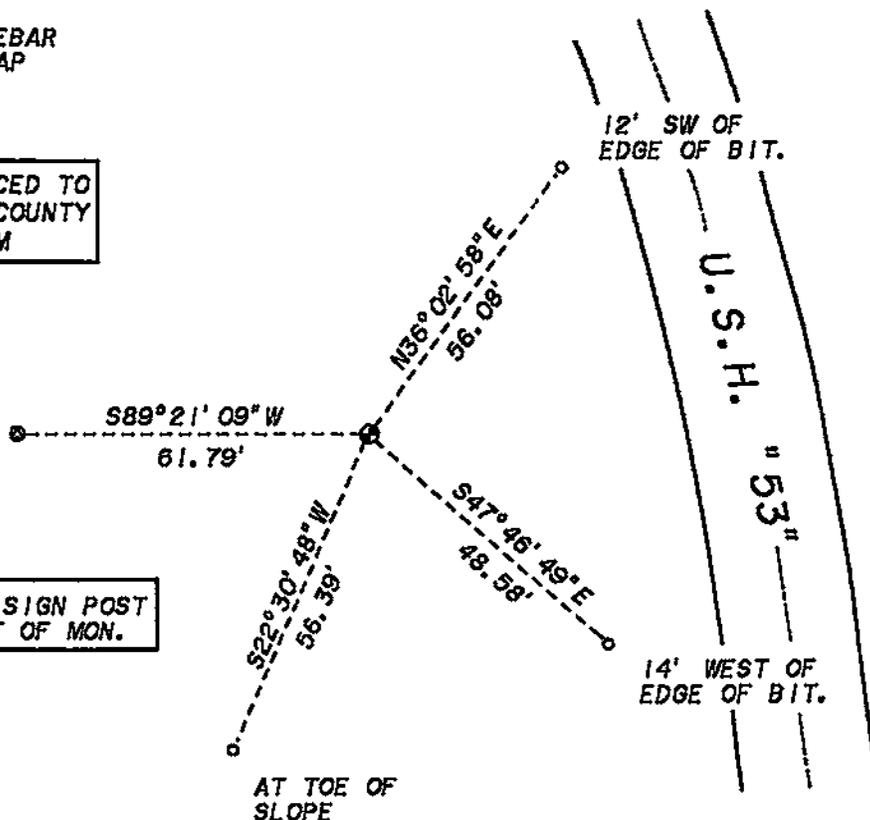

Corner Identifier number 56-292

Describe any material discrepancy between the location of the corner as restored or reestablished and the location of that corner as previously restored or reestablished by distance and direction. Show the discrepancy on the plan view drawing. Show the distances between the corner as restored or reestablished, and (1) the corner as restored or reestablished, and (2) to at least 2 of the witness monuments shown on the drawing.

NO ACTUAL MONUMENT DISCREPANCY WAS FOUND, ALTHOUGH RECORDS INDICATE THAT A DIFFERENT POSITION WAS USED BY THE DEPARTMENT OF TRANSPORTATION IN 1979 AND BY S. SOLBERG IN 1989. THIS REESTABLISHED POSITION TO THE OTHER RECORDED POSITION - EASTERLY, APPROXIMATELY 4.7 FEET.

Was the corner restored through acceptance of (1) an obliterated evidence location, (2) a found perpetuated location, or (3) an existent corner location?

N/A.

Was the corner reestablished through lost corner proportionate methods? If so, show the method including the directions and distances to othe public land survey corners used as evidence or used for proportioning in determining the corner location.

**YES. SINGLE PROPORTIONATE MEASUREMENT WAS USED BETWEEN THE NORTHEAST AND SOUTHEAST CORNERS OF SECTION 2-18-8.
NORTHEAST CORNER TO EAST QUARTER CORNER - $500^{\circ}07'21''$ W, 2469.88 FEET.
EAST QUARTER CORNER TO SOUTHEAST CORNER - $500^{\circ}07'21''$ W, 2624.74 FEET.
(BEARINGS REFERENCED TO THE TREMPLEAU COUNTY COORDINATE SYSTEM)**

Show the corner history of record in chronological order from Original Government Survey to present.

**ORIGINAL GOVERNMENT SURVEY - CYRUS WOODWORTH - SEPTEMBER 1847
SET QUARTER SECTION POST. MARKED TWO BEARING TREES.**

**MISC. SURVEY NOTES - COUNTY SURVEYOR'S OFFICE - DATE?
SHOWS COORDINATE VALUES FOR VARIOUS LOCATIONS IN SECTION 2-18-8 AREA.**

**RIGHT OF WAY PLAT - DEPT. OF TRANSPORTATION - FEBRUARY 1979
RIGHT OF WAY PLAT FOR HUNTER'S BRIDGE PROJECT. SHOWS COORDINATE POSITION FOR NORTHEAST, EAST QUARTER AND SOUTHEAST CORNERS OF SECTION 2-18-8.**

**PRIVATE LAND SURVEYOR'S RECORDS - D. KROHN - APRIL 1981
SURVEYS PARCEL IN SECTION 1-18-8. SETS A P.K. NAIL AT THE SINGLE PROPORTIONATE POSITION TO MONUMENT THE WEST QUARTER CORNER OF SECTION 1-18-8. ALSO SHOWS A FOUND P.K. NAIL EASTERLY APPROXIMATELY 4.7 FEET FROM SET NAIL.**

**PRIVATE LAND SURVEYOR'S RECORDS - T. KERWIN - DECEMBER 1988
SURVEYS PARCEL IN SECTION 2-18-8. SHOWS LOCATION OF THE EAST QUARTER CORNER OF SECTION 2. NO MENTION OF WHAT WAS FOUND OR SET.**

**PRIVATE LAND SURVEYOR'S RECORDS - S. SOLBERG - JULY & SEPTEMBER 1989
FILES TWO SURVEYS OF PARCELS LOCATED IN SECTION 2-18-8. BOTH SURVEYS TIE TO THE EAST QUARTER CORNER OF SECTION 2. NEITHER SHOWS WHAT WAS USED.**

**PRIVATE LAND SURVEYOR'S RECORDS - R. CONNELL - MAY 1985
SURVEYS PARCEL IN SECTION 1-18-8. CALLS FOR "CORNER OF RECORD" AT THE WEST QUARTER CORNER OF SECTION 1. NO MENTION OF MONUMENT TYPE.**

Affix Land Surveyor Seal

I, JOSEPH P. NELSEN
certify that the corner location shown on this record was determined by me or under my direction and control and that this U.S. Public Land Survey Monument Record is correct to the best of my knowledge and belief.

Joseph P. Nelsen 10-7-99
Signature Date

