

21808030020

# TREMPEALEAU COUNTY


## U.S. PUBLIC LAND SURVEY MONUMENT RECORD

QUARTER Corner common to Sections 3 & 10

T. 18 N., R. 8 W.

Type of monument 7/8" X30" REBAR WITH ALUMINUM CAP

Location indicated on sketch - -

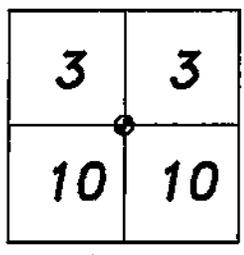


Location Sketch

Describe any record evidence, monument evidence, occupational evidence, testimonial evidence or any other material evidence you considered, and whether the monument was found or placed.

ORIGINAL GOVERNMENT ACCESSORIES WERE SEARCHED FOR, BUT NOTHING WAS FOUND. OTHER MONUMENT EVIDENCE WAS SEARCHED FOR, AND A 1" IRON PIPE WAS FOUND. NO RECORD EVIDENCE OF THE IRON PIPE WAS FOUND. IRON PIPE COULD POSSIBLY BE INTENDED AS CONTROL ONLY. MISCELLANEOUS SURVEY NOTES ON FILE AT THE COUNTY SURVEYOR'S OFFICE INDICATE THAT A POSITION FOR THIS CORNER WAS DETERMINED BY SINGLE PROPORTIONATE MEASUREMENT BETWEEN THE NORTHWEST AND NORTHEAST CORNERS OF SECTION 10-18-8. INFORMATION ON THE 1985 SURVEY BY R. CHALSMAN INDICATES THAT THE SINGLE PROPORTIONATE POSITION WAS USED FOR HIS SURVEY. OTHER SURVEYS THAT WOULD REQUIRE THIS CORNER POSITION, SEEM TO HOLD FOUND MONUMENTATION AT INTERIOR 1/16TH CORNERS IN SECTION 3-18-8, WITHOUT RECORD OF PROPER SECTION PROTRACTION. THEREFORE, THIS CORNER WAS REESTABLISHED, AT THIS TIME, BY HOLDING SINGLE PROPORTIONATE MEASUREMENT BETWEEN THE NORTHWEST AND NORTHEAST CORNERS OF SECTION 10-18-8. THIS POSITION IS LOCATED APPROXIMATELY ON A REMNANT, CROOKED FENCE LINE NORTH AND APPROXIMATELY 14 FEET NORTH OF A CROOKED, REMNANT FENCE LINE WEST. THE REMNANT FENCE LINE TO THE WEST APPEARS TO BE A SHORT FENCE LINE THAT COULD POSSIBLY HAVE BEEN PLACED AS A CONVENIENCE FENCE LINE ALONG THE EDGE OF THE FIELD, AND WAS THEREFORE NOT CONSIDERED AS GOOD EVIDENCE OF THIS CORNER'S LOCATION. THEREFORE, BELIEVING THIS POSITION, AS DESCRIBED, TO BE THE BEST AVAILABLE EVIDENCE OF THIS CORNER'S ORIGINAL LOCATION, A 7/8" X30" REBAR WITH AN ALUMINUM CAP WAS SET AND REFERENCED AS SHOWN BELOW.

Show a plan view drawing depicting the relevant monuments, providing reference ties to at least 4 witness monuments. Describe witness monuments. Show relationship to occupation.

o SET 5/8" X24" REBAR WITH PLASTIC CAP

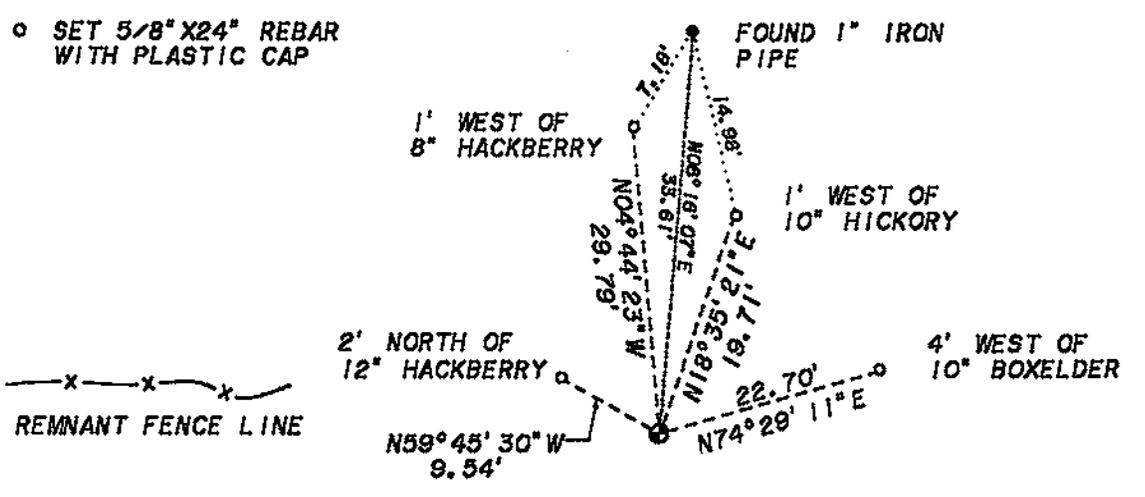

REM NANT FENCE LINE



no scale

SURVEY SIGN POST  
1' NORTH OF MON.

BEARINGS REFERENCED TO  
THE TREMPEALEAU COUNTY  
COORDINATE SYSTEM

Corner Identifier number 68-296

Describe any material discrepancy between the location of the corner as restored or reestablished and the location of that corner as previously restored or reestablished by distance and direction. Show the discrepancy on the plan view drawing. Show the distances between the corner as restored or reestablished, and (1) the corner as restored or reestablished, and (2) to at least 2 of the witness monuments shown on the drawing.

**NO RECORD MONUMENT DISCREPANCY WAS FOUND, ALTHOUGH THIS REESTABLISHED POSITION DOES NOT MATCH A FOUND 1" IRON PIPE. REESTABLISHED CORNER TO FOUND 1" IRON PIPE = N06°16'07"E, 33.61 FEET.  
(BEARING REFERENCED TO THE TREMPLEAU COUNTY COORDINATE SYSTEM)**

Was the corner restored through acceptance of (1) an obliterated evidence location, (2) a found perpetuated location, or (3) an existent corner location?

**N/A.**

Was the corner reestablished through lost corner proportionate methods? If so, show the method including the directions and distances to other public land survey corners used as evidence or used for proportioning in determining the corner location.

**YES. SINGLE PROPORTIONATE MEASUREMENT WAS USED BETWEEN THE NORTHWEST AND NORTHEAST CORNERS OF SECTION 10-18-8.  
NORTHWEST CORNER TO NORTH QUARTER CORNER = N89°53'47"E, 2635.14 FEET.  
NORTH QUARTER CORNER TO NORTHEAST CORNER = N89°53'47"E, 2635.14 FEET.  
(BEARINGS REFERENCED TO THE TREMPLEAU COUNTY COORDINATE SYSTEM)**

Show the corner history of record in chronological order from Original Government Survey to present.

**ORIGINAL GOVERNMENT SURVEY - CYRUS WOODWORTH - SEPTEMBER 1847  
SET QUARTER SECTION POST. MARKED TWO BEARING TREES.**

**MISC. SURVEY NOTES - COUNTY SURVEYOR'S OFFICE - DATE?  
SHOWS COORDINATE VALUES FOR VARIOUS LOCATIONS IN SECTION 10-18-8.**

**PRIVATE LAND SURVEYOR'S RECORDS - P. SMITH - AUGUST 1976  
SURVEYS PARCEL IN SECTION 3-18-8. TIES SURVEY TO THE CENTER OF SECTION 3.**

**PRIVATE LAND SURVEYOR'S RECORDS - P. SMITH - OCTOBER 1977  
SURVEYS PARCEL IN SECTION 3-18-8. TIES SURVEY TO INTERIOR 1/16TH CORNER.**

**PRIVATE LAND SURVEYOR'S RECORDS - S. SOLBERG - DATE?  
SURVEYS PARCEL IN SECTION 3-18-8. TIES SURVEY TO INTERIOR 1/16TH CORNER.**

**PRIVATE LAND SURVEYOR'S RECORDS - R. CHALSMA - MAY 1985  
SURVEYS PARCEL IN SECTION 3-18-8. TIES SURVEY TO CENTER OF SECTION 3.**

**PRIVATE LAND SURVEYOR'S RECORDS - R. CHALSMA - JUNE 1985  
SURVEYS PARCELS IN SECTION 10-18-8. INFORMATION ON SURVEY INDICATES THE NORTH QUARTER CORNER OF SECTION 10 WOULD HAVE BEEN REQUIRED FOR SURVEY, HOWEVER, NO MENTION OF NORTH QUARTER CORNER.**

**PRIVATE LAND SURVEYOR'S RECORDS - T. KERWIN - MAY 1984  
SURVEYS PARCEL IN SECTION 3-18-8. INFORMATION ON SURVEY INDICATES THE SOUTH QUARTER CORNER OF SECTION 3 WOULD HAVE BEEN REQUIRED FOR SURVEY, HOWEVER, NO MENTION OF SOUTH QUARTER CORNER.**

Affix Land Surveyor Seal

I, JOSEPH P. NELSEN  
certify that the corner location shown on this record was determined by me or under my direction and control and that this U.S. Public Land Survey Monument Record is correct to the best of my knowledge and belief.

Joseph P. Nelsen 10-6-99  
Signature Date

