

21808032000

TREMPEALEAU COUNTY


U.S. PUBLIC LAND SURVEY MONUMENT RECORD

QUARTER Corner common to Sections 2 8 3

T. 18 N., R. 8 W.

Type of monument 7/8" X60" REBAR WITH ALUMINUM CAP

Location indicated on sketch -  -

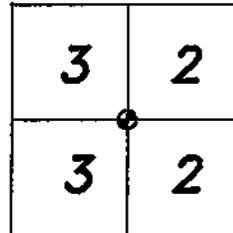


Location Sketch

Describe any record evidence, monument evidence, occupational evidence, testimonial evidence or any other material evidence you considered, and whether the monument was found or placed.

ORIGINAL GOVERNMENT ACCESSORIES WERE SEARCHED FOR, BUT NOTHING WAS FOUND. OTHER MONUMENT EVIDENCE WAS SEARCHED FOR, BUT NONE WAS FOUND. ORIGINAL GOVERNMENT EVIDENCE OF THE MEANDER CORNER 594 FEET SOUTH OF THIS CORNER WAS ALSO SEARCHED FOR, BUT NOTHING WAS FOUND. A 1969 SURVEY, BY AN UNKNOWN SURVEYOR, INDICATES A POSITION FOR THIS CORNER, APPARENTLY AT THE INTERSECTION OF NORTH/SOUTH AND EAST/WEST FENCE LINES. THE MAP OF THIS 1969 SURVEY SHOWS A SYMBOL AT THE CORNER LOCATION, BUT DOES NOT INDICATE WHAT WAS FOUND OR SET. THIS FENCE INTERSECTION WAS SEARCHED FOR. THE ONLY FENCE LINE FOUND WAS A SHORT EAST/WEST FENCE LINE. MISCELLANEOUS SURVEY NOTES, ON FILE AT THE COUNTY SURVEYOR'S OFFICE, INDICATE THAT A POSITION FOR THIS CORNER WAS DETERMINED BY SINGLE PROPORTIONATE MEASUREMENT BETWEEN THE NORTHEAST AND SOUTHEAST CORNERS OF SECTION 3-18-8. SURVEYS FILED IN BOTH LA CROSSE COUNTY AND IN TREMPEALEAU COUNTY INDICATE UTILIZING CORNER POSITIONS DEPENDENT ON THIS COMPUTED CORNER LOCATION. THIS POSITION MATCHES ORIGINAL GOVERNMENT DISTANCE TO BOTH THE NORTHEAST AND SOUTHEAST CORNERS OF SECTION 3-18-8 BY ABOUT 4 FEET. IT ALSO MATCHES THE NORTH/SOUTH POSITION OF A FOUND IRON PIPE NEAR THE CENTER OF SECTION 3-18-8 BY LESS THAN 10 FEET. THIS POSITION IS APPROXIMATELY 120 FEET SOUTH OF THE FOUND EAST/WEST FENCE LINE. THE ORIGINAL GOVERNMENT SURVEY NOTES THE BLACK RIVER TO BE 9 CHAINS (594 FEET) SOUTH OF THIS CORNER. AN APPARENT OLD RIVER BANK WAS FOUND APPROXIMATELY 520 FEET SOUTH OF THIS CORNER POSITION. THE LOCATION OF THE BLACK RIVER APPEARS TO HAVE CHANGED MANY TIMES OVER THE LAST 150 YEARS, RENDERING THE ORIGINAL GOVERNMENT CALL FOR THE RIVER INAPPROPRIATE TO ASSIST IN DETERMINING THIS CORNER LOCATION. THEREFORE, BELIEVING THE SINGLE PROPORTIONATE MEASUREMENT POSITION, AS DESCRIBED, TO BE THE BEST AVAILABLE EVIDENCE OF THIS CORNER'S ORIGINAL LOCATION, A 7/8" X60" REBAR WITH AN ALUMINUM CAP WAS SET AND REFERENCED AS SHOWN BELOW.

Show a plan view drawing depicting the relevant monuments, providing reference ties to at least 4 witness monuments. Describe witness monuments. Show relationship to occupation.

o SET 5/8" X24" REBAR WITH PLASTIC CAP

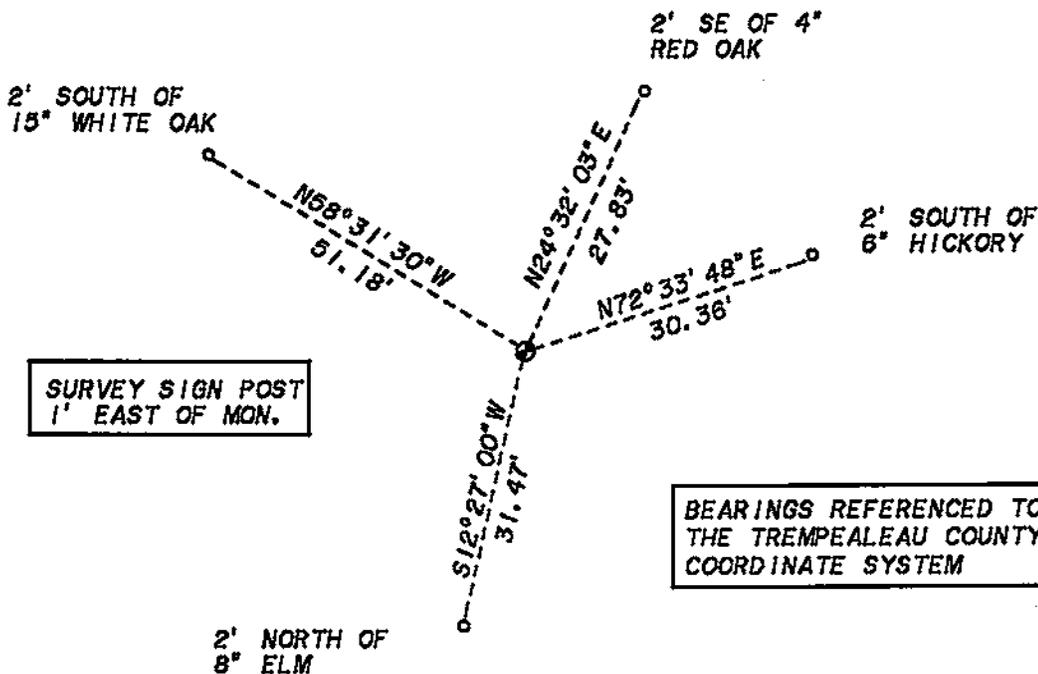

no scale

Corner Identifier number

64-292

Describe any material discrepancy between the location of the corner as restored or reestablished and the location of that corner as previously restored or reestablished by distance and direction. Show the discrepancy on the plan view drawing. Show the distances between the corner as restored or reestablished, and (1) the corner as restored or reestablished, and (2) to at least 2 of the witness monuments shown on the drawing.

NO ACTUAL MONUMENT DISCREPANCY WAS FOUND, ALTHOUGH THIS POSITION MAY NOT REFLECT THE EXACT POSITION REQUIRED FOR VARIOUS SURVEYS LOCATED IN SECTION 3-18-8.

Was the corner restored through acceptance of (1) an obliterated evidence location, (2) a found perpetuated location, or (3) an existent corner location?

N/A.

Was the corner reestablished through lost corner proportionate methods? If so, show the method including the directions and distances to other public land survey corners used as evidence or used for proportioning in determining the corner location.

**YES. SINGLE PROPORTIONATE MEASUREMENT WAS USED BETWEEN THE NORTHEAST AND SOUTHEAST CORNERS OF SECTION 3-18-8.
NORTHEAST CORNER TO EAST QUARTER CORNER = $500^{\circ}05'04''$ W, 2494.81 FEET
EAST QUARTER CORNER TO SOUTHEAST CORNER = $500^{\circ}05'04''$ W, 2635.83 FEET
(BEARINGS REFERENCED TO THE TREMPLEAU COUNTY COORDINATE SYSTEM)**

Show the corner history of record in chronological order from Original Government Survey to present.

**ORIGINAL GOVERNMENT SURVEY - CYRUS WOODWORTH - SEPTEMBER 1847
SET QUARTER SECTION POST. MARKED TWO BEARING TREES.**

**PRIVATE LAND SURVEYOR'S RECORDS - NAME? - MARCH 1969
SURVEYS A PARCEL IN SECTION 3-18-8. SHOWS A SYMBOL AT THE EAST QUARTER CORNER OF SECTION 3. NO MENTION OF WHAT WAS FOUND OR SET. MAP APPEARS TO INDICATE THE CORNER TO BE AT THE INTERSECTION OF FENCE LINES NORTH/SOUTH AND EAST/WEST.**

**MISC. SURVEY NOTES - COUNTY SURVEYOR'S OFFICE - DATE?
SHOWS COORDINATE VALUES FOR VARIOUS LOCATIONS IN SECTION 3-18-8 AREA.**

**PRIVATE LAND SURVEYOR'S RECORDS - P. SMITH - AUGUST 1976
SURVEYS PARCEL IN SECTION 3-18-8. TIES SURVEY TO THE CENTER OF SECTION 3.**

**PRIVATE LAND SURVEYOR'S RECORDS - P. SMITH - OCTOBER 1977
SURVEYS PARCEL IN SECTION 3-18-8. TIES SURVEY TO INTERIOR 1/16TH CORNER.**

**PRIVATE LAND SURVEYOR'S RECORDS - S. SOLBERG - DATE?
SURVEYS PARCEL IN SECTION 3-18-8. TIES SURVEY TO INTERIOR 1/16TH CORNER.**

**PRIVATE LAND SURVEYOR'S RECORDS - R. CHALSMAN - MAY 1985
SURVEYS PARCEL IN SECTION 3-18-8. TIES SURVEY TO CENTER OF SECTION 3.**

I, JOSEPH P. NELSEN
certify that the corner location shown on this record was determined by me or under my direction and control and that this U.S. Public Land Survey Monument Record is correct to the best of my knowledge and belief.

Joseph P. Nelsen 10-6-99
Signature Date

Affix Land Surveyor Seal

