

TREMPEALEAU COUNTY


U.S. PUBLIC LAND SURVEY MONUMENT RECORD

SECTION Corner common to Sections 3, 4, 9 & 10

T. 18 N., R. 8 W.

Type of monument 7/8" X30" REBAR WITH ALUMINUM CAP

Location indicated on sketch -  -

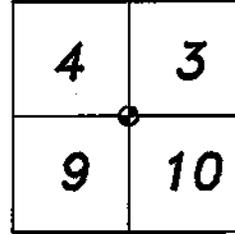


Location Sketch

Describe any record evidence, monument evidence, occupational evidence, testimonial evidence or any other material evidence you considered, and whether the monument was found or placed.

ORIGINAL GOVERNMENT ACCESSORIES WERE SEARCHED FOR, BUT NOTHING WAS FOUND. OTHER MONUMENT EVIDENCE WAS SEARCHED FOR, AND A BENT 2" IRON PIPE WAS FOUND AT THE ROAD SURFACE. DUE TO THIS CORNER POSITION BEING LOCATED IN AN EXISTING ROADWAY, IT WAS EXCAVATED WITH BACK HOE IN SEARCH OF SUBSURFACE MONUMENT EVIDENCE. NO OTHER MONUMENT EVIDENCE WAS FOUND. THE VERTICAL POSITION FOR THIS IRON PIPE WAS DETERMINED. THIS POSITION FALLS APPROXIMATELY 4 FEET WESTERLY OF A CROOKED NORTH/SOUTH ROAD CENTERLINE. THIS POSITION MATCHES THE MONUMENT DESCRIPTION AND LOCATION AS CALLED FOR BY C. SOLBERG IN 1980 AND BY S. SOLBERG IN 1989. IT ALSO MATCHES THE COORDINATE POSITION AS INDICATED IN MISCELLANEOUS FIELD NOTES, ON FILE AT THE COUNTY SURVEYOR'S OFFICE. THEREFORE, BELIEVING FOUND IRON PIPE, AS DESCRIBED, TO BE THE BEST AVAILABLE EVIDENCE OF THIS CORNER'S ORIGINAL LOCATION, A 7/8" X30" REBAR WITH AN ALUMINUM CAP WAS SET IN ITS PLACE AND REFERENCED AS SHOWN BELOW.

Show a plan view drawing depicting the relevant monuments, providing reference ties to at least 4 witness monuments. Describe witness monuments. Show relationship to occupation.

- o SET 5/8" X24" REBAR WITH PLASTIC CAP

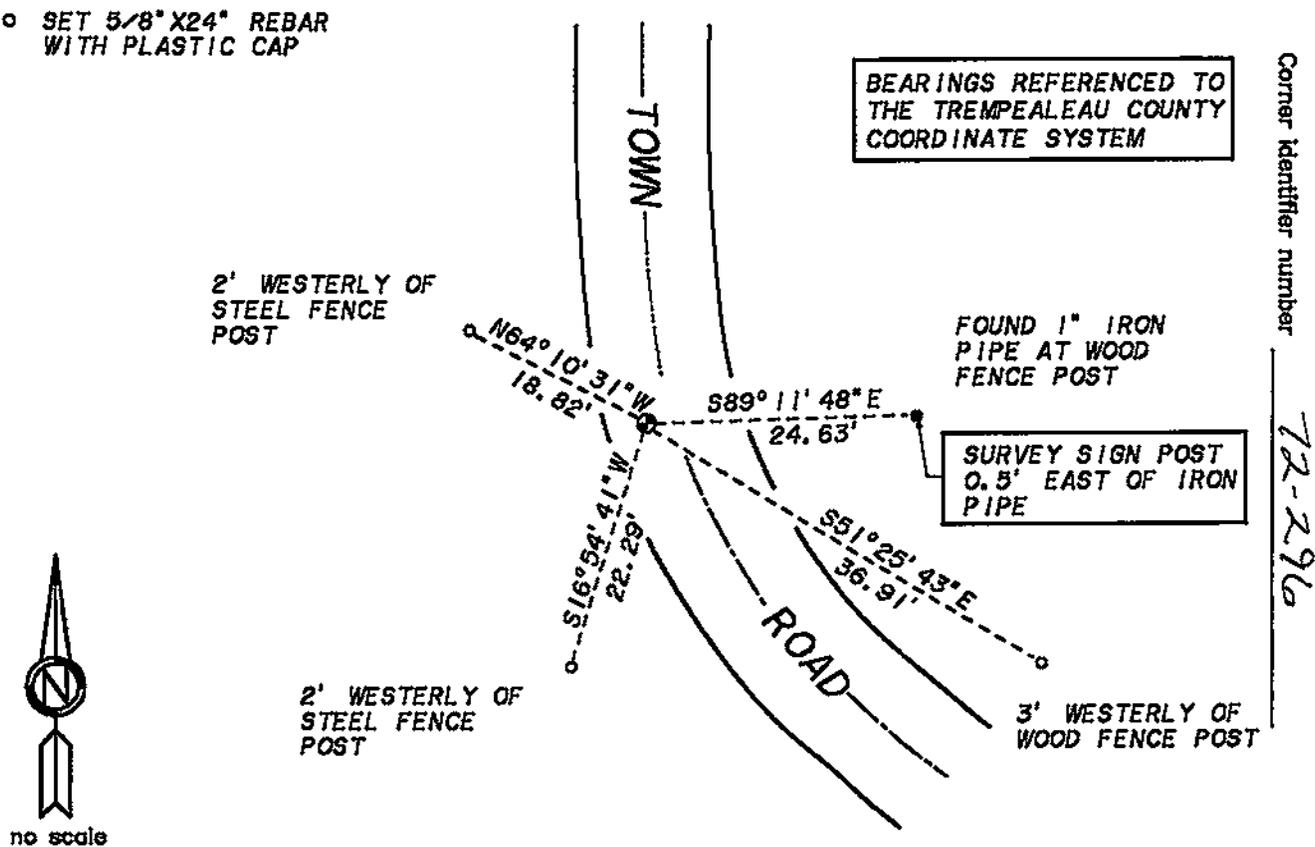

Describe any material discrepancy between the location of the corner as restored or reestablished and the location of that corner as previously restored or reestablished by distance and direction. Show the discrepancy on the plan view drawing. Show the distances between the corner as restored or reestablished, and (1) the corner as restored or reestablished, and (2) to at least 2 of the witness monuments shown on the drawing.

NO MATERIAL DISCREPANCY WAS FOUND.

Was the corner restored through acceptance of (1) an obliterated evidence location, (2) a found perpetuated location, or (3) an existent corner location?

A FOUND PERPETUATED LOCATION.

Was the corner reestablished through lost corner proportionate methods? If so, show the method including the directions and distances to other public land survey corners used as evidence or used for proportioning in determining the corner location.

NO.

Show the corner history of record in chronological order from Original Government Survey to present.

**ORIGINAL GOVERNMENT SURVEY - CYRUS WOODWORTH - SEPTEMBER 1847
SET POST TO SECTION CORNER. MARKED TWO BEARING TREES.**

**MISC. SURVEY NOTES - COUNTY SURVEYOR'S OFFICE - DATE?
SHOWS COORDINATE VALUES FOR VARIOUS LOCATIONS IN SECTION 9-18-8.**

**PRIVATE LAND SURVEYOR'S RECORDS - C. SOLBERG - DECEMBER 1980
SURVEYS PARCEL IN SECTION 4-18-8. CALLS FOR A FOUND 2" IRON PIPE AT THE
SOUTHEAST CORNER OF SECTION 4.**

**PRIVATE LAND SURVEYOR'S RECORDS - S. SOLBERG - MARCH 1989
SURVEYS PARCEL IN SECTION 4-18-8. CALLS FOR A FOUND 2" IRON PIPE AT THE
SOUTHEAST CORNER OF SECTION 4.**

I, JOSEPH P. NELSEN
certify that the corner location shown on this record
was determined by me or under my direction and control
and that this U.S. Public Land Survey Monument Record
is correct to the best of my knowledge and belief.

Joseph P. Nelsen 10-4-99
Signature Date

Affix Land Surveyor Seal

