

21808042000

TREMPEALEAU COUNTY


U.S. PUBLIC LAND SURVEY MONUMENT RECORD

QUARTER Corner common to Sections 3 8 4

T. 18 N., R. 8 W.

Type of monument ALUMINUM CAPPED MONUMENT

Location indicated on sketch - ⊕ -

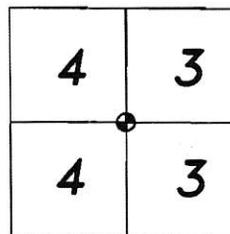


Location Sketch

Describe any record evidence, monument evidence, occupational evidence, testimonial evidence or any other material evidence you considered, and whether the monument was found or placed.

ORIGINAL GOVERNMENT ACCESSORIES WERE SEARCHED FOR, BUT NOTHING WAS FOUND. OTHER MONUMENT EVIDENCE WAS SEARCHED FOR AND AN ALUMINUM MONUMENT WAS FOUND. MONUMENT WAS FOUND ON A REMNANT FENCE LINE NORTH/SOUTH AND APPROXIMATELY 14 FEET NORTH OF A SHORT, CROOKED, REMNANT FENCE LINE WEST. ALSO FOUND FOUR 1" IRON PIPE REFERENCE MONUMENTS. NO OTHER MONUMENT EVIDENCE WAS FOUND. ACCORDING TO RECORD INFORMATION, T. KERWIN SET A MONUMENT AT THIS POSITION IN 1980. S. SOLBERG STATES THAT HE SET A MONUMENT AT THIS CORNER IN 1987. BASED ON THE RECORD INFORMATION IT APPEARS AS THOUGH THIS MONUMENT WAS SET BY T. KERWIN IN 1980 AND WAS LATER FOUND AND REFERENCED IN 1987 BY S. SOLBERG. FOUND MONUMENT MATCHES THE SINGLE PROPORTIONATE POSITION BY ABOUT 0.2 FEET EAST/WEST AND BY LESS THAN 0.5 FEET NORTH/SOUTH. FOUND MONUMENT MATCHES MEASUREMENT INFORMATION AS INDICATED IN MISCELLANEOUS SURVEY NOTES REASONABLY WELL. THEREFORE BELIEVING FOUND MONUMENT, AS DESCRIBED, TO BE THE BEST AVAILABLE EVIDENCE OF THIS CORNER'S ORIGINAL LOCATION, IT WAS LEFT IN PLACE AND REFERENCED AS SHOWN BELOW.

Show a plan view drawing depicting the relevant monuments, providing reference ties to at least 4 witness monuments. Describe witness monuments. Show relationship to occupation.

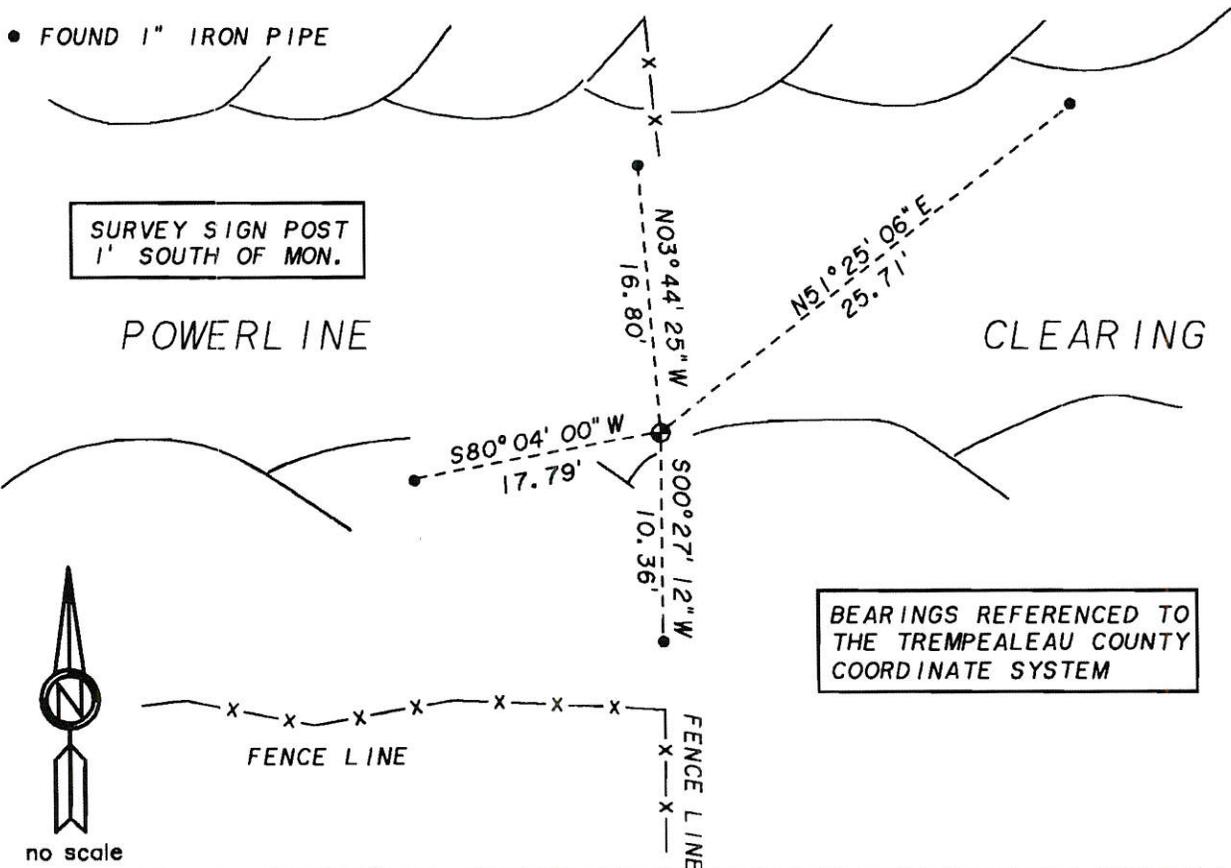

Describe any material discrepancy between the location of the corner as restored or reestablished and the location of that corner as previously restored or reestablished by distance and direction. Show the discrepancy on the plan view drawing. Show the distances between the corner as restored or reestablished, and (1) the corner as restored or reestablished, and (2) to at least 2 of the witness monuments shown on the drawing.

NO MATERIAL DISCREPANCY WAS FOUND.

Was the corner restored through acceptance of (1) an obliterated evidence location, (2) a found perpetuated location, or (3) an existent corner location?

A FOUND PERPETUATED LOCATION.

Was the corner reestablished through lost corner proportionate methods? If so, show the method including the directions and distances to other public land survey corners used as evidence or used for proportioning in determining the corner location.

NO.

Show the corner history of record in chronological order from Original Government Survey to present.

**ORIGINAL GOVERNMENT SURVEY - CYRUS WOODWORTH - SEPTEMBER 1847
SET QUARTER SECTION POST. MARKED TWO BEARING TREES.**

**MISC. SURVEY NOTES - COUNTY SURVEYOR'S OFFICE - DATE ?
SHOWS COORDINATE VALUES FOR VARIOUS CORNER LOCATIONS IN SECTION 3-18-8.**

**RECORD OF LAND CORNER PERPETUATION - T. KERWIN - DECEMBER 1980
FILES TIE SHEET FOR THE WEST QUARTER CORNER OF SECTION 3-18-8. ONLY
INFORMATION NOTED IS "SET MONUMENT 12-10-80".**

**PRIVATE LAND SURVEYOR'S RECORDS - S. SOLBERG - MAY 1987
SURVEYS PARCELS IN SECTION 4-18-8 AND IN SECTION 33-19-8. CALLS FOR A
FOUND MONUMENT WITH A BRASS CAP.**

**RECORD OF LAND CORNER PERPETUATION - S. SOLBERG - NOVEMBER 1987
FILES TIE SHEET FOR THE EAST QUARTER CORNER OF SECTION 4-18-8. STATES
THAT HE SET THIS MONUMENT BY PROPORTIONATE MEASUREMENT. ALSO SHOWS FOUR
1" IRON PIPE REFERENCE TIES.**

I, JOSEPH P. NELSEN
certify that the corner location shown on this record
was determined by me or under my direction and control
and that this U.S. Public Land Survey Monument Record
is correct to the best of my knowledge and belief.

Joseph P. Nelsen 1-18-2000
Signature Date

Affix Land Surveyor Seal

