


TREMPEALEAU COUNTY

U.S. PUBLIC LAND SURVEY MONUMENT RECORD

SECTION Corner common to Sections 8, 9, 16 & 17
 T. 18 N., R. 8 W.
 Type of monument 7/8" X30" REBAR WITH ALUMINUM CAP
 Location indicated on sketch -  -

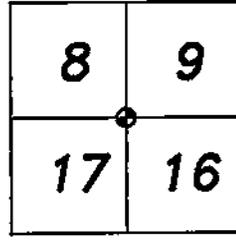

Location Sketch

Describe any record evidence, monument evidence, occupational evidence, testimonial evidence or any other material evidence you considered, and whether the monument was found or placed.

ORIGINAL GOVERNMENT ACCESSORIES WERE SEARCHED FOR, BUT NOTHING WAS FOUND. OTHER MONUMENT EVIDENCE WAS SEARCHED FOR, SUCH AS THE "P.K." NAIL CALLED FOR BY S. SOLBERG IN 1986 AND CALLED FOR BY R. CHALSMAN IN 1990, BUT NOTHING WAS FOUND. APPARENTLY CALLED FOR "P.K." NAIL WAS LOST TO ROAD MAINTENANCE. DUE TO THIS CORNER POSITION BEING LOCATED IN AN EXISTING ROADBED, IT WAS EXCAVATED WITH BACK HOE IN SEARCH OF SUBSURFACE MONUMENT EVIDENCE. AT ORIGINAL GRADE, A 7" X11" X16", VERTICALLY PLACED, STONE MONUMENT WAS FOUND. WOOD POST REMNANTS WERE FOUND DIRECTLY UNDER STONE MONUMENT. WOOD POST REMNANTS ARE BELIEVED TO BE FROM THE ORIGINAL WOOD POST OR FROM A SUBSEQUENT RESURVEY MONUMENT. STONE MONUMENT WAS FOUND APPROXIMATELY ON NORTH/SOUTH ROAD CENTERLINE AND APPROXIMATELY ON A REMNANT FENCE LINE EAST. STONE MONUMENT WAS FOUND APPROXIMATELY 1 FOOT NORTHWESTERLY OF THE RETRACED POSITION OF SAID "P.K." NAIL. THIS POSITION MATCHES ORIGINAL GOVERNMENT DISTANCE TO THE EAST QUARTER CORNER OF SECTION 8-18-8 BY LESS THAN 3 FEET. IT ALSO MATCHES ORIGINAL GOVERNMENT DISTANCE TO THE EAST QUARTER CORNER OF SECTION 17-18-8 BY ABOUT 4 FEET. THEREFORE, BELIEVING FOUND STONE MONUMENT, AS DESCRIBED, TO BE THE BEST AVAILABLE EVIDENCE OF THIS CORNER'S ORIGINAL LOCATION, A 7/8" X30" REBAR WAS SET IN ITS PLACE AND REFERENCED AS SHOWN BELOW.

Show a plan view drawing depicting the relevant monuments, providing reference ties to at least 4 witness monuments. Describe witness monuments. Show relationship to occupation.

o SET 5/8" X24" REBAR WITH PLASTIC CAP


3' SOUTH OF POWER POLE

BEARINGS REFERENCED TO THE TREMPEALEAU COUNTY COORDINATE SYSTEM



no scale

SURVEY SIGN POST
1' SW OF REF. MON.

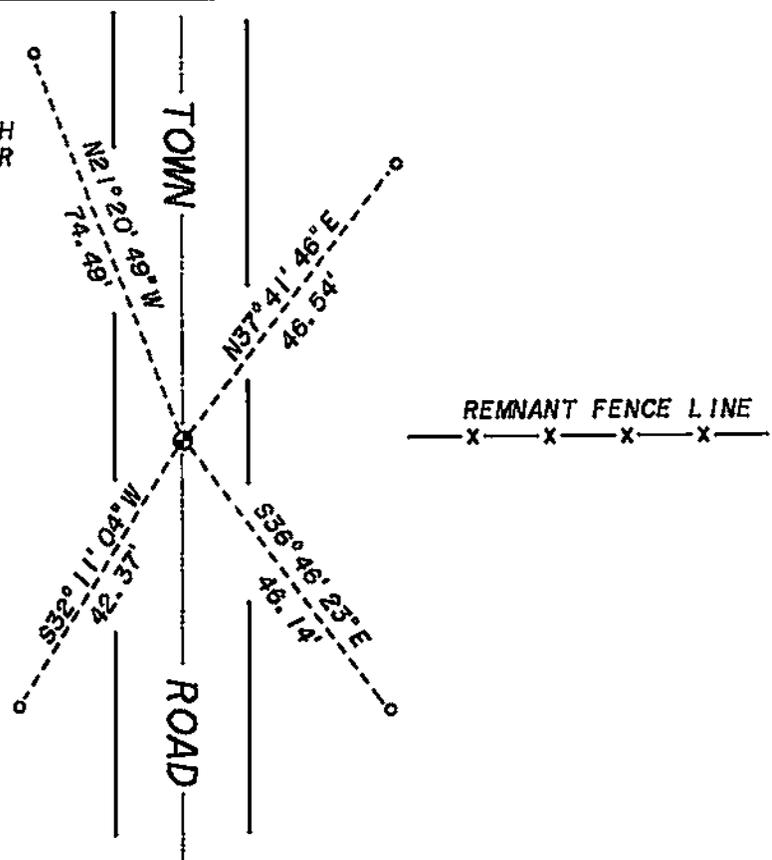

Corner Identifier number

80-304

Describe any material discrepancy between the location of the corner as restored or reestablished and the location of that corner as previously restored or reestablished by distance and direction. Show the discrepancy on the plan view drawing. Show the distances between the corner as restored or reestablished, and (1) the corner as restored or reestablished, and (2) to at least 2 of the witness monuments shown on the drawing.

NO ACTUAL MONUMENT DISCREPANCY WAS FOUND, ALTHOUGH THIS RESTORED POSITION DOES NOT MATCH A POSITION REQUIRED BY S. SOLBERG SURVEY OF 1986 AND SURVEY BY R. CHALSMA IN 1990, IN WHICH A "P.K." NAIL WAS CALLED FOR. RESTORED CORNER TO APPROXIMATE LOCATION OF CALLED FOR "P.K." NAIL - S41°E, 1.2 FEET.

Was the corner restored through acceptance of (1) an obliterated evidence location, (2) a found perpetuated location, or (3) an existent corner location?

A FOUND PERPETUATED LOCATION.

Was the corner reestablished through lost corner proportionate methods? If so, show the method including the directions and distances to other public land survey corners used as evidence or used for proportioning in determining the corner location.

NO.

Show the corner history of record in chronological order from Original Government Survey to present.

**ORIGINAL GOVERNMENT SURVEY - CYRUS WOODWORTH - SEPTEMBER 1847
SET POST TO SECTION CORNER. MARKED TWO BEARING TREES.**

**PRIVATE LAND SURVEYOR'S RECORDS - S. SOLBERG - DECEMBER 1986
SURVEYS PARCEL IN SECTION 16-18-8. CALLS FOR A FOUND "P.K." NAIL AT THE
NORTHWEST CORNER OF SECTION 16.**

**PRIVATE LAND SURVEYOR'S RECORDS - R. CHALSMA - JANUARY 1990
SURVEYS PARCEL IN SECTION 17-18-8. CALLS FOR A FOUND "P.K." AT THE
NORTHEAST CORNER OF SECTION 17.**

I, JOSEPH P. NELSEN
certify that the corner location shown on this record
was determined by me or under my direction and control
and that this U.S. Public Land Survey Monument Record
is correct to the best of my knowledge and belief.

Signature

Date

Joseph P. Nelsen 9-29-99

Affix Land Surveyor Seal

