

# LA CROSSE COUNTY


## U.S. PUBLIC LAND SURVEY MONUMENT RECORD

SECTION Corner common to Sections 9, 10, 15 & 16

T. 18 N., R. 8 W.

Type of monument NO MONUMENT SET

Location indicated on sketch -  -

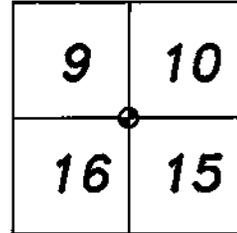

Location Sketch

Describe any record evidence, monument evidence, occupational evidence, testimonial evidence or any other material evidence you considered, and whether the monument was found or placed.

ORIGINAL GOVERNMENT SURVEY FOUND THIS CORNER TO FALL IN THE BLACK RIVER. APPARENTLY NO MONUMENT WAS SET AND NO BEARING TREES WERE RECORDED. THE ORIGINAL GOVERNMENT SURVEY DOES INDICATE A POSITION FOR THIS CORNER BASED ON THE EAST LINE OF SECTION 16-18-8, THE EAST LINE OF SECTION 9-18-8 AND THE NORTH LINE OF SECTION 15-18-8. THE NORTH LINE OF SECTION 16-18-8 WAS RUN AS A TRUE EAST LINE AND TERMINATED AT THE BLACK RIVER WITHOUT CLOSING ON THIS CORNER. ACCORDING TO A VARIETY OF AERIAL PHOTOGRAPHS OF THIS AREA, THE BLACK RIVER HAS CHANGED COURSE SINCE THE ORIGINAL GOVERNMENT SURVEY, POSSIBLY MANY TIMES. NO RECORD EVIDENCE OF ANY SUBSEQUENT SURVEYS AT THIS CORNER LOCATION WAS FOUND. THEREFORE, BELIEVING THIS CORNER TO BE LOST, IT WAS REESTABLISHED BY HOLDING THREE POINT CONTROL. THE NORTH/SOUTH POSITION WAS REESTABLISHED BY HOLDING THE PROPORTIONAL SPLIT OF DISTANCE BETWEEN THE NORTHEAST CORNER OF SECTION 9-18-8 AND THE EAST QUARTER CORNER OF SECTION 16-18-8. THE EAST/WEST POSITION WAS REESTABLISHED BY HOLDING ORIGINAL GOVERNMENT DISTANCE FROM THE NORTHEAST CORNER OF SECTION 15-18-8. MEASUREMENT TO THE WEST OF THIS CORNER WAS NOT TAKEN INTO CONSIDERATION DUE TO THE FACT THAT THE ORIGINAL GOVERNMENT SURVEY RAN THE NORTH LINE OF SECTION 16-18-8 AS "TRUE" WITHOUT CLOSING ON THIS CORNER. THEREFORE, BELIEVING THIS POSITION, AS DESCRIBED, TO BE THE BEST AVAILABLE EVIDENCE OF THIS CORNER'S ORIGINAL LOCATION, A COMPUTED POSITION WAS DOCUMENTED AS INDICATED ON THIS SHEET.

Show a plan view drawing depicting the relevant monuments, providing reference ties to at least 4 witness monuments. Describe witness monuments. Show relationship to occupation.

NO MONUMENT WAS SET. POSITION LOCATED IN SWAMPY BACK WATER OF THE BLACK RIVER. PLEASE REFER TO SECTION DATA SHEETS ON FILE AT THE COUNTY SURVEYOR'S OFFICE FOR COORDINATE POSITION OF THIS CORNER.

Corner Identifier number 72-304



no scale

Describe any material discrepancy between the location of the corner as restored or reestablished and the location of that corner as previously restored or reestablished by distance and direction. Show the discrepancy on the plan view drawing. Show the distances between the corner as restored or reestablished, and (1) the corner as restored or reestablished, and (2) to at least 2 of the witness monuments shown on the drawing.

**NO VERIFIED DISCREPANCY WAS FOUND, ALTHOUGH THIS RESTORED POSITION DOES NOT REFLECT AN APPARENT COMPUTED POSITION AS NOTED IN MISC. SURVEY NOTES. THIS RESTORED POSITION TO COMPUTED POSITION =  $380^{\circ}22'58''E$ , 15.01 FEET. (BEARING REFERENCED TO THE TREMPAEALU COUNTY COORIDNATE SYSTEM)**

Was the corner restored through acceptance of (1) an obliterated evidence location, (2) a found perpetuated location, or (3) an existent corner location?

**NO.**

Was the corner reestablished through lost corner proportionate methods? If so, show the method including the directions and distances to othe public land survey corners used as evidence or used for proportioning in determining the corner location.

**YES. PROPORTIONATE MEASUREMENT USING THREE POINT CONTROL FROM THE NORTHEAST CORNER OF SECTION 15-18-8 AND THE NORTHEAST CORNER OF SECTION 9-18-8 AND THE EAST QUARTER CORNER OF SECTION 16-18-8.  
NE CORNER SECTION 9 TO NE CORNER SECTION 16 =  $301^{\circ}11'50''E$ , 5258.72 FEET.  
NE CORNER SECTION 16 TO EAST QUARTER COR. SEC. 16 =  $900^{\circ}11'06''E$ , 2629.36 FEET.  
NE CORNER SECTION 15 TO NE CORNER SECTION 16 =  $N89^{\circ}57'19''W$ , 5230.50 FEET.  
(BEARINGS REFERENCED TO THE TREMPAEALU COUNTY COORDINATE SYSTEM)**

Show the corner history of record in chronological order from Original Government Survey to present.

**ORIGINAL GOVERNMENT SURVEY - CYRUS WOODWORTH - SEPTEMBER 1847  
AT 80 CHAINS CORNER TO SECTIONS. (APPARENTLY THIS CORNER FELL IN THE BLACK RIVER, AS MEANDER POSTS WERE SET ON SECTION LINES AT ALL FOUR DIRECTIONS.**

**MISC. SURVEY NOTES - COUNTY SURVEYOR'S OFFICE - DATE ?  
SHOWS COORDINATE VALUES FOR VARIOUS LOCATIONS IN SECTION 9-18-8 AREA.**

I, JOSEPH P. NELSEN  
certify that the corner location shown on this record was determined by me or under my direction and control and that this U.S. Public Land Survey Monument Record is correct to the best of my knowledge and belief.

Joseph P. Nelsen 9-29-99  
Signature Date

Affix Land Surveyor Seal

