

TREMPEALEAU COUNTY


U.S. PUBLIC LAND SURVEY MONUMENT RECORD

QUARTER Corner common to Sections 9 & 16

T. 18 N., R. 8 W.

Type of monument 7/8" X30" REBAR WITH ALUMINUM CAP

Location indicated on sketch -  -

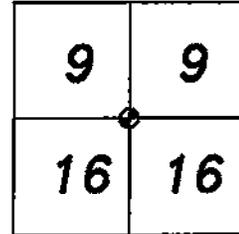

Location Sketch

Describe any record evidence, monument evidence, occupational evidence, testimonial evidence or any other material evidence you considered, and whether the monument was found or placed.

ORIGINAL GOVERNMENT ACCESSORIES WERE SEARCHED FOR, BUT NOTHING WAS FOUND. OTHER MONUMENT EVIDENCE WAS SEARCHED FOR, BUT NONE WAS FOUND. MISCELLANEOUS SURVEY NOTES ON FILE AT THE COUNTY SURVEYOR'S OFFICE INDICATE A COMPUTED POSITION NEAR THIS CORNER LOCATION. IT IS UNCLEAR IF THIS COMPUTED POSITION WAS INTENDED TO BE AN APPROXIMATE POSITION FOR SEARCHING OR A POSITION FOR THE CORNER. THE ORIGINAL GOVERNMENT SURVEYOR ESTABLISHED THIS POSITION FROM THE NORTHWEST CORNER OF SECTION 16-18-8 AS FOLLOWS: EAST ON TRUE LINE BETWEEN SECTIONS 9 AND 16, AT 40 CHAINS SET QUARTER SECTION POST AND MARKED TWO BEARING TREES. THE ORIGINAL GOVERNMENT SURVEYOR DID NOT RUN A RANDOM LINE TO THE NORTHEAST CORNER OF SECTION 16, AND CORRECT BACK, AS NORMALLY WOULD BE THE CASE. THE LINE WAS RUN AS "TRUE" AND TERMINATED AT THE BANK OF THE BLACK RIVER. ACCORDING TO AERIAL PHOTOGRAPHY THIS AREA, IT APPEARS AS THOUGH THE BLACK RIVER HAS CHANGED LOCATION IN THIS AREA. THE NORTH/SOUTH POSITION OF THIS CORNER WAS DETERMINED BY HOLDING OCCUPATIONAL EVIDENCE, CONSISTING OF AN EAST/WEST FENCE LINE. THE EAST/WEST POSITION OF THIS CORNER WAS BASED ON LOST CORNER METHODS, USING SINGLE POINT CONTROL FROM THE NORTHWEST CORNER OF SECTION 16-18-8. THIS METHOD WAS UTILIZED DUE TO INDICATIONS ON THE ORIGINAL GOVERNMENT PLAT AND IN THE ORIGINAL GOVERNMENT FIELD NOTES THAT THIS CORNER WAS ORIGINALLY SET IN THIS FASHION. THIS POSITION IS LOCATED APPROXIMATELY 39 FEET NORTHERLY OF SAID COMPUTED POSITION. THEREFORE, BELIEVING THIS POSITION, AS DESCRIBED, TO BE THE BEST AVAILABLE EVIDENCE OF THIS CORNER'S ORIGINAL LOCATION, A 7/8" X30" REBAR WAS SET AND REFERENCED AS SHOWN BELOW.


Show a plan view drawing depicting the relevant monuments, providing reference ties to at least 4 witness monuments. Describe witness monuments. Show relationship to occupation.

o SET 5/8" X24" REBAR WITH PLASTIC CAP

24" BELOW THE SURFACE IN CULT. (NO CAP)

BEARINGS REFERENCED TO THE TREMPEALEAU COUNTY COORDINATE SYSTEM

SURVEY SIGN POST 1' NORTH OF MON.

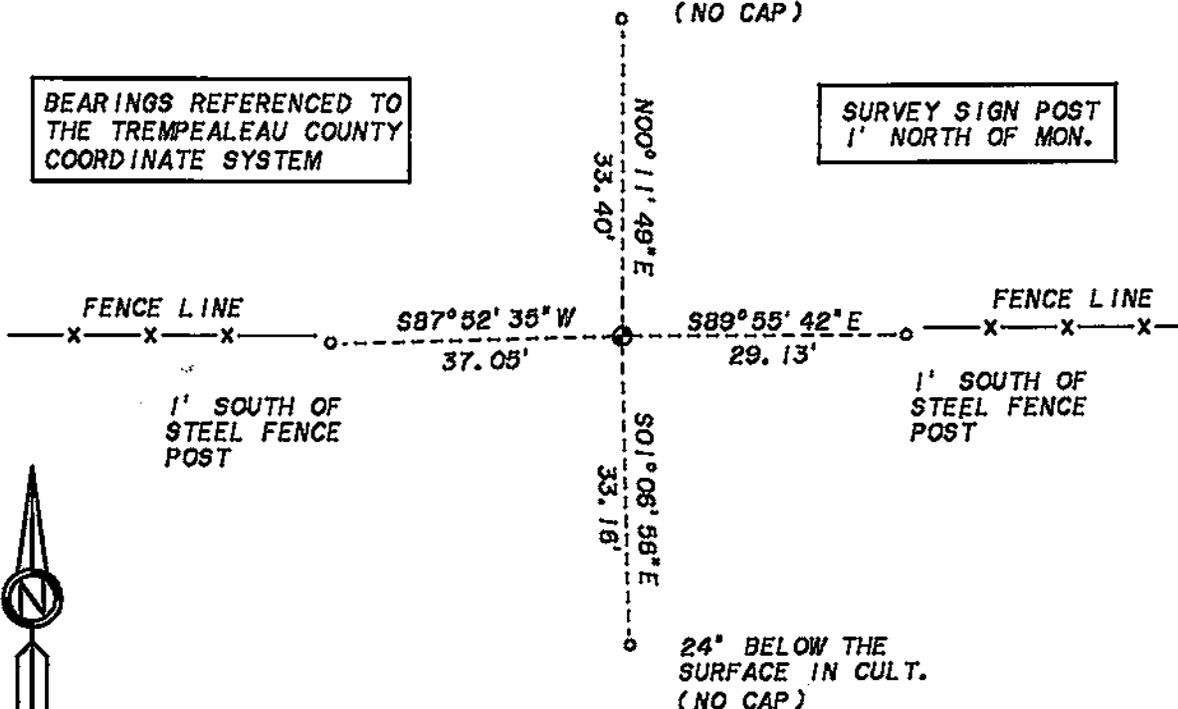

Corner Identifier number

76-304



no scale

