

LA CROSSE COUNTY


U.S. PUBLIC LAND SURVEY MONUMENT RECORD

SECTION Corner common to Sections 10, 11, 14 & 15

T. 18 N., R. 8 W.

Type of monument NO MONUMENT SET

Location indicated on sketch -  -

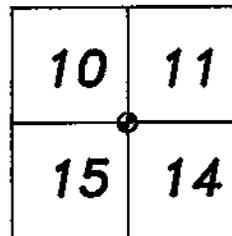

Location Sketch

Describe any record evidence, monument evidence, occupational evidence, testimonial evidence or any other material evidence you considered, and whether the monument was found or placed.

THIS CORNER LOCATION FALLS IN THE FLOOD PRONE BACK WATERS OF THE BLACK RIVER. IT IS BELIEVED THAT ANY EVIDENCE OF THE ORIGINAL GOVERNMENT PIT AND MOUND HAS BEEN LOST TO NEARLY ANNUAL FLOODWATERS. ORTHOPHOTOGRAPHY FOR THIS AREA WAS PREPARED IN 1972. ONE OF THE GOALS OF THIS PHOTOGRAPHY WAS TO PROVIDE COORDINATE LOCATIONS OF MANMADE AND NATURAL FEATURES THAT MAY AFFECT GOVERNMENT CORNER LOCATIONS, SUCH AS FENCE LINES, RIVERS, CREEKS, ETC.. THIS PHOTOGRAPHY SHOWS A FENCE INTERSECTION AT THIS CORNER LOCATION. ACCORDING TO MISCELLANEOUS SURVEY NOTES, ON FILE AT THE COUNTY SURVEYOR'S OFFICE, THIS FENCE INTERSECTION WAS HELD AS THE LOCATION OF THIS CORNER AND A COORDINATE POSITION WAS DETERMINED. OTHER GOVERNMENT CORNERS IN THIS AREA WERE COMPUTED BASED ON THE COORDINATE POSITION OF THIS FENCE CORNER. IT IS BELIEVED THAN OVER 25 YEARS OF NEARLY ANNUAL FLOODWATERS MAY HAVE OBLITERATED THIS OCCUPATION. SURVEYS FILED IN BOTH LA CROSSE COUNTY AND TREMPLEAU COUNTY INDICATE UTILIZING CORNER POSITIONS DEPENDENT ON THE COORDINATE POSITION OF THIS FENCE INTERSECTION. THIS POSITION MATCHES ORIGINAL GOVERNMENT DISTANCE TO THE NORTHEAST CORNER OF SECTION 3-18-8 BY APPROXIMATELY 16 FEET. IT MATCHES ORIGINAL GOVERNMENT DISTANCE TO THE NORTHEAST CORNER OF SECTION 14-18-8 BY LESS THAN 32 FEET. IT ALSO MATCHES ORIGINAL GOVERNMENT DISTANCE TO AN APPROXIMATE POSITION OF THE NORTHEAST CORNER OF SECTION 22-18-8 BY LESS THAN 40 FEET. THEREFORE, BELIEVING THIS POSITION, AS DESCRIBED, TO BE THE BEST AVAILABLE EVIDENCE OF THIS CORNER'S ORIGINAL LOCATION, A COMPUTED POSITION WAS DOCUMENTED AS INDICATE ON THIS SHEET.

Show a plan view drawing depicting the relevant monuments, providing reference ties to at least 4 witness monuments. Describe witness monuments. Show relationship to occupation.

NO MONUMENT SET. POSITION LOCATED IN SWAMPY BACK WATER OF THE BLACK RIVER. PLEASE REFER TO SECTION DATA SHEETS ON FILE AT THE COUNTY SURVEYOR'S OFFICE FOR COORDINATE POSITION OF THIS CORNER.

Corner Identifier number

04-304



no scale

Describe any material discrepancy between the location of the corner as restored or reestablished and the location of that corner as previously restored or reestablished by distance and direction. Show the discrepancy on the plan view drawing. Show the distances between the corner as restored or reestablished, and (1) the corner as restored or reestablished, and (2) to at least 2 of the witness monuments shown on the drawing.

NO MATERIAL DISCREPANCY WAS FOUND:

Was the corner restored through acceptance of (1) an obliterated evidence location, (2) a found perpetuated location, or (3) an existent corner location?

AN OBLITERATED EVIDENCE LOCATION.

Was the corner reestablished through lost corner proportionate methods? If so, show the method including the directions and distances to other public land survey corners used as evidence or used for proportioning in determining the corner location.

NO.

Show the corner history of record in chronological order from Original Government Survey to present.

**ORIGINAL GOVERNMENT SURVEY - CYRUS WOODWORTH - SEPTEMBER 1847
SET POST IN MOUND. PIT 8 LINKS SOUTH.**

**ORTHOGRAPHY - COUNTY SURVEYOR'S OFFICE - 1972
ORTHOGRAPHY PROVIDED FOR T. 18N., R. 8W. INDICATES OCCUPATION LINES,
CREEKS AND OTHER MAN MADE AND NATURAL FEATURES. OCCUPATIONAL EVIDENCE
CONSISTING OF FENCE INTERSECTION INDICATED.**

**MISC. SURVEY NOTES - COUNTY SURVEYOR'S OFFICE - DATE?
SHOWS COORDINATE VALUES FOR VARIOUS LOCATIONS IN SECTION 10-18-8 AREA.**

I, JOSEPH P. NELSEN
certify that the corner location shown on this record
was determined by me or under my direction and control
and that this U.S. Public Land Survey Monument Record
is correct to the best of my knowledge and belief.

Joseph P. Nelsen 10-6-99
Signature Date

Affix Land Surveyor Seal

