

21808100020

LA CROSSE COUNTY


U.S. PUBLIC LAND SURVEY MONUMENT RECORD

QUARTER Corner common to Sections 10 & 15

T. 18 N., R. 8 W.

Type of monument NO MONUMENT SET

Location indicated on sketch -- ⊙ --

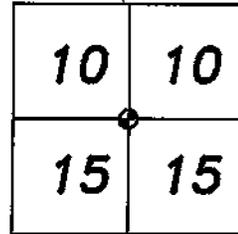

Location Sketch

Describe any record evidence, monument evidence, occupational evidence, testimonial evidence or any other material evidence you considered, and whether the monument was found or placed.

THIS CORNER LOCATION FALLS IN THE FLOOD PRONE BACK WATERS OF THE BLACK RIVER. IT IS BELIEVED THAT ANY EVIDENCE OF THE ORIGINAL GOVERNMENT MONUMENT OR BEARING TREES HAS BEEN LOST TO NEARLY ANNUAL FLOODWATERS. ORTHOPHOTOGRAPHY FOR THIS AREA WAS PREPARED IN 1972. ONE OF THE GOALS OF THIS PHOTOGRAPHY WAS TO PROVIDE COORDINATE LOCATIONS OF MANMADE AND NATURAL FEATURES THAT MAY AFFECT GOVERNMENT CORNER LOCATIONS, SUCH AS FENCE LINES, RIVERS, CREEKS, ETC.. THIS PHOTOGRAPHY DOES NOT SHOW ANY INFORMATION AT THIS POSITION THAT WOULD ASSIST IN DETERMINING THIS CORNER LOCATION. MISCELLANEOUS SURVEY NOTES, ON FILE AT THE COUNTY SURVEYOR'S OFFICE, INDICATE THAT A POSITION FOR THIS CORNER WAS DETERMINED BY SINGLE PROPORTIONATE MEASUREMENT BETWEEN THE NORTHWEST AND NORTHEAST CORNERS OF SECTION 15-18-8. ACCORDING TO DATA ON R. CHALSMAN SURVEY OF 1885, THIS SINGLE PROPORTIONATE POSITION WAS USED FOR HIS SURVEY. IN THIS 1999 SURVEY, IT WAS DETERMINED THAT THE COMPUTED POSITION FOR THE NORTHWEST CORNER OF SECTION 15-18-8, AS INDICATED IN SAID MISCELLANEOUS SURVEY NOTES, WAS INAPPROPRIATELY DETERMINED, THEREBY RENDERING THE COMPUTED POSITION OF THIS QUARTER CORNER INCORRECT. THEREFORE THIS CORNER WAS DETERMINED TO BE LOST AND WAS REESTABLISHED BY SINGLE PROPORTIONATE MEASUREMENT BETWEEN THE NORTHWEST AND NORTHEAST CORNERS OF SECTION 15-18-8. BELIEVING THIS POSITION, AS DESCRIBED, TO BE THE BEST AVAILABLE EVIDENCE OF THIS CORNER'S ORIGINAL LOCATION, A COMPUTED POSITION WAS DOCUMENTED AS INDICATE ON THIS SHEET.

Show a plan view drawing depicting the relevant monuments, providing reference ties to at least 4 witness monuments. Describe witness monuments. Show relationship to occupation.

NO MONUMENT SET. POSITION LOCATED IN SWAMPY BACK WATER OF THE BLACK RIVER. PLEASE REFER TO SECTION DATA SHEETS ON FILE AT THE COUNTY SURVEYOR'S OFFICE FOR COORDINATE POSITION OF THIS CORNER.

Corner Identifier number

68-304



no scale

Describe any material discrepancy between the location of the corner as restored or reestablished and the location of that corner as previously restored or reestablished by distance and direction. Show the discrepancy on the plan view drawing. Show the distances between the corner as restored or reestablished, and (1) the corner as restored or reestablished, and (2) to at least 2 of the witness monuments shown on the drawing.

**NO VERIFIED DISCREPANCY WAS FOUND, ALTHOUGH THIS REESTABLISHED POSITION DOES NOT REFLECT AN APPARENT COMPUTED POSITION, AS NOTED IN MISC. SURVEY NOTES ON FILE AT THE TREMPLEAU COUNTY SURVEYOR'S OFFICE.
REESTABLISHED POSITION TO APPARENT COMPUTED POSITION = S50°23'E, 7.50 FEET.
(BEARING REFERENCED TO THE TREMPLEAU COUNTY COORDINATE SYSTEM)**

Was the corner restored through acceptance of (1) an obliterated evidence location, (2) a found perpetuated location, or (3) an existent corner location?

N/A.

Was the corner reestablished through lost corner proportionate methods? If so, show the method including the directions and distances to other public land survey corners used as evidence or used for proportioning in determining the corner location.

**YES. SINGLE PROPORTIONATE MEASUREMENT WAS USED BETWEEN THE NORTHWEST AND NORTHEAST CORNERS OF SECTION 15-18-8.
NORTHWEST CORNER TO NORTH QUARTER CORNER = S89°57' 19"E, 2615.25 FEET.
NORTH QUARTER CORNER TO NORTHEAST CORNER = S89°57' 19"E, 2615.25 FEET.
(BEARINGS REFERENCED TO THE TREMPLEAU COUNTY COORDINATE SYSTEM)**

Show the corner history of record in chronological order from Original Government Survey to present.

**ORIGINAL GOVERNMENT SURVEY - CYRUS WOODWORTH - SEPTEMBER 1847
SET QUARTER SECTION POST. MARKED TWO BEARING TREES.**

**ORTHOGRAPHY - COUNTY SURVEYOR'S OFFICE - 1972
ORTHOGRAPHY PROVIDED FOR T. 18N., R. 8W. INDICATES OCCUPATION LINES,
CREEKS AND OTHER MAN MADE AND NATURAL FEATURES. NO INDICATION AT THIS
CORNER LOCATION OF REMAINING CORNER EVIDENCE.**

**MISC. SURVEY NOTES - COUNTY SURVEYOR'S OFFICE - DATE?
SHOWS COORDINATE VALUES FOR VARIOUS LOCATIONS IN SECTION 10-18-8 AREA.**

**PRIVATE LAND SURVEYOR'S RECORDS - R. CHALSMAN - JUNE 1985
SURVEYS PARCELS IN SECTION 10-18-8. INFORMATION ON SURVEY INDICATES
THE SOUTH QUARTER CORNER OF SECTION 10 WOULD HAVE BEEN REQUIRED FOR
SURVEY, HOWEVER, NO MENTION OF SOUTH QUARTER CORNER.**

I, JOSEPH P. NELSEN
certify that the corner location shown on this record
was determined by me or under my direction and control
and that this U.S. Public Land Survey Monument Record
is correct to the best of my knowledge and belief.

Joseph P. Nelsen 10-6-99
Signature Date

Affix Land Surveyor Seal

