

LA CROSSE COUNTY


U.S. PUBLIC LAND SURVEY MONUMENT RECORD

QUARTER Corner common to Sections 10 & 11

T. 18 N., R. 8 W.

Type of monument NO MONUMENT SET

Location indicated on sketch - ⊙ -

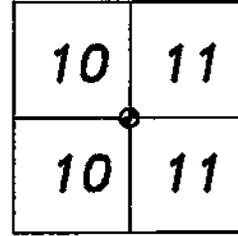

Location Sketch

Describe any record evidence, monument evidence, occupational evidence, testimonial evidence or any other material evidence you considered, and whether the monument was found or placed.

THIS CORNER LOCATION FALLS IN THE FLOOD PRONE BACK WATERS OF THE BLACK RIVER. IT IS BELIEVED THAT ANY EVIDENCE OF THE ORIGINAL GOVERNMENT MONUMENT AND BEARING TREE HAS BEEN LOST TO NEARLY ANNUAL FLOODWATERS. ORTHOPHOTOGRAPHY FOR THIS AREA WAS PREPARED IN 1972. ONE OF THE GOALS OF THIS PHOTOGRAPHY WAS TO PROVIDE COORDINATE LOCATIONS OF MANMADE AND NATURAL FEATURES THAT MAY AFFECT GOVERNMENT CORNER LOCATIONS, SUCH AS FENCE LINES, RIVERS, CREEKS, ETC.. THIS PHOTOGRAPHY DOES NOT SHOW ANY INFORMATION AT THIS POSITION THAT WOULD ASSIST IN DETERMINING THIS CORNER LOCATION. MISCELLANEOUS SURVEY NOTES, ON FILE AT THE COUNTY SURVEYOR'S OFFICE, INDICATE A POSITION FOR THIS CORNER WAS DETERMINED BY SINGLE PROPORTIONATE MEASUREMENT BETWEEN THE NORTHEAST AND SOUTHEAST CORNERS OF SECTION 10-18-8. SURVEY PREPARED BY R. BERG IN 1985 INDICATES UTILIZING A COMPUTED POSITION FOR THIS CORNER. DATA SHOWN ON 1985 SURVEY BY R. CHALSMAN ALSO INDICATES UTILIZING THIS COMPUTED POSITION. THIS POSITION MATCHES ORIGINAL GOVERNMENT DISTANCE TO BOTH THE NORTHEAST AND SOUTHEAST CORNER OF SECTION 10-18-8 BY ABOUT 4 FEET. THEREFORE, BELIEVING THE SINGLE PROPORTIONATE MEASUREMENT POSITION, AS DESCRIBED, TO BE THE BEST AVAILABLE EVIDENCE OF THIS CORNER'S ORIGINAL LOCATION, A COMPUTED POSITION WAS DOCUMENTED AS INDICATE ON THIS SHEET.

Show a plan view drawing depicting the relevant monuments, providing reference ties to at least 4 witness monuments. Describe witness monuments. Show relationship to occupation.

NO MONUMENT SET. POSITION LOCATED IN SWAMPY BACK WATER OF THE BLACK RIVER. PLEASE REFER TO SECTION DATA SHEETS ON FILE AT THE COUNTY SURVEYOR'S OFFICE FOR COORDINATE POSITION OF THIS CORNER.

Corner Identifier number

64-300



no scale

Describe any material discrepancy between the location of the corner as restored or reestablished and the location of that corner as previously restored or reestablished by distance and direction. Show the discrepancy on the plan view drawing. Show the distances between the corner as restored or reestablished, and (1) the corner as restored or reestablished, and (2) to at least 2 of the witness monuments shown on the drawing.

NO MATERIAL DISCREPANCY WAS FOUND.

Was the corner restored through acceptance of (1) an obliterated evidence location, (2) a found perpetuated location, or (3) an existent corner location?

N/A.

Was the corner reestablished through lost corner proportionate methods? If so, show the method including the directions and distances to other public land survey corners used as evidence or used for proportioning in determining the corner location.

**YES. SINGLE PROPORTIONATE MEASUREMENT WAS USED BETWEEN THE NORTHEAST AND SOUTHEAST CORNERS OF SECTION 10-18-8.
NORTHEAST CORNER TO EAST QUARTER CORNER = $900^{\circ}45'43''$ E, 2635.82 FEET.
EAST QUARTER CORNER TO SOUTHEAST CORNER = $900^{\circ}45'43''$ E, 2635.82 FEET.
(BEARINGS REFERENCED TO THE TREMPLEAU COUNTY COORDINATE SYSTEM)**

Show the corner history of record in chronological order from Original Government Survey to present.

**ORIGINAL GOVERNMENT SURVEY - CYRUS WOODWORTH - SEPTEMBER 1847
SET QUARTER SECTION POST. MARKED ONE BEARING TREE.**

**ORTHOGRAPHY - COUNTY SURVEYOR'S OFFICE - 1972
ORTHOGRAPHY PROVIDED FOR T. 18N., R. 8W. INDICATES OCCUPATION LINES, CREEKS AND OTHER MAN MADE AND NATURAL FEATURES. NO INDICATION AT THIS CORNER LOCATION OF REMAINING CORNER EVIDENCE.**

**MISC. SURVEY NOTES - COUNTY SURVEYOR'S OFFICE - DATE?
SHOWS COORDINATE VALUES FOR VARIOUS LOCATIONS IN SECTION 10-18-8 AREA.**

**CERTIFIED SURVEY MAP - R. BERG - MARCH 1985
SURVEYS PARCEL IN SECTION 11-18-8. CALLS FOR WEST QUARTER CORNER OF SECTION 11 AS LOCATION CALCULATED USING COORDINATES ESTABLISHED BY TREMPLEAU COUNTY SURVEYOR. NO MONUMENT SET.**

**PRIVATE LAND SURVEYOR'S RECORDS - R. CHALSMA - JUNE 1988
SURVEYS PARCELS IN SECTION 10-18-8. INFORMATION ON SURVEY INDICATES THE EAST QUARTER CORNER OF SECTION 10 WOULD HAVE BEEN REQUIRED FOR SURVEY, HOWEVER, NO MENTION OF EAST QUARTER CORNER.**

I, JOSEPH P. NELSEN
certify that the corner location shown on this record was determined by me or under my direction and control and that this U.S. Public Land Survey Monument Record is correct to the best of my knowledge and belief.

Joseph P. Nelsen
Signature

Date

Affix Land Surveyor Seal

