


U. S. PUBLIC LAND SURVEY MONUMENT RECORD

SECTION 13 T 18 N, R 8 W, TOWN OF HOLLAND

LA CROSSE COUNTY

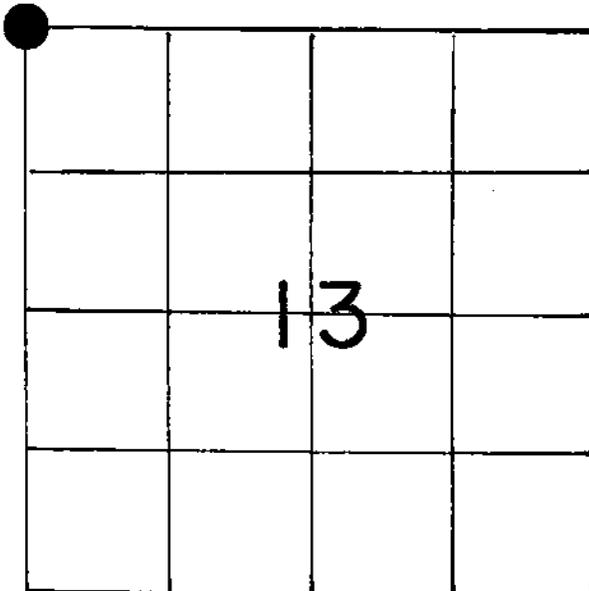

LOCATION OF LANDMARK

Crew: WILLIAM C. JUNG
PETER F. FOLLANSBEE

Date: 9/08/1993

Describe any record evidence, monument evidence, testimonial evidence or any other material evidence you considered and whether the monument was found or restored through acceptance of an obliterated evidence location.

I set the corner at Terry Kerwin's computed corner location, the location of which he and I agreed on. I set a bolt at the final location. I did not set a Lunde marker because of the close proximity of underground utility lines.

Describe or show any material discrepancy between the location of the restored corner and that of the corner previously restored or reestablished.

None Known

WISCONSIN COORDINATE SYSTEM

North

East

Theta Angle

Horiz. Order

Vert. Order

TYPE OF LANDMARK


Set 5/8" x 12" Flathead Bolt.

BEARINGS ARE REFERENCED TO

Centerline of U.S. Highway "53"
as shown on Terry Kerwin's survey,
dated 5/28/90, located in the
NW $\frac{1}{4}$ -NW $\frac{1}{4}$, Section 13-18-8


RECORD OF DURABLE WITNESS MONUMENTS

NO	DESCRIPTION	BEARING	DISTANCE
1	Set P.K. Nail in NE-side 21" Oak (unblazed)	Northwesterly \pm	87.50 Ft.
2	Set P.K. Nail in SW-side light pole	Northwesterly \pm	50.33 Ft.
3	Distance to center of steel sign post	Southwesterly \pm	8.05 Ft.
4	Distance to centerline of U.S.H. "53"	East \pm	91.7' \pm

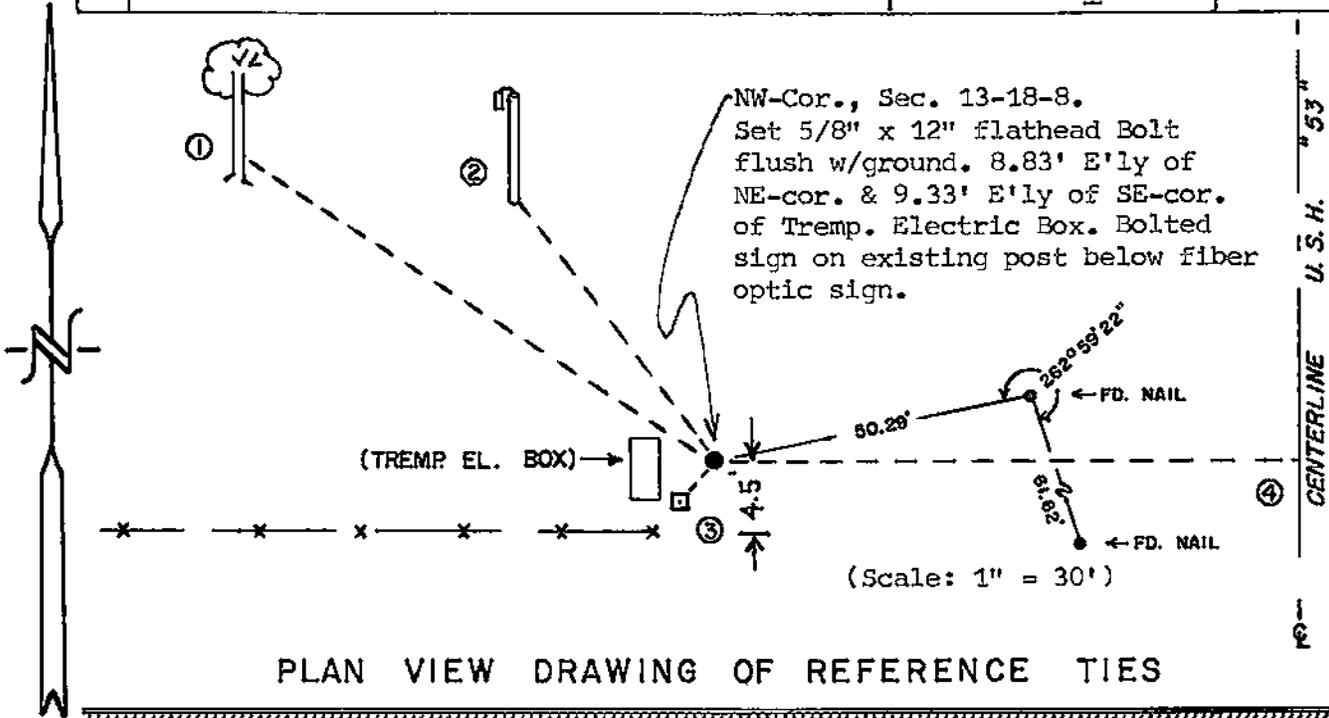


MAP SHOWING DISTANCE AND DIRECTION TO OTHER PUBLIC LAND SURVEY CORNERS USED FOR REESTABLISHING THE CORNER

(not to scale)

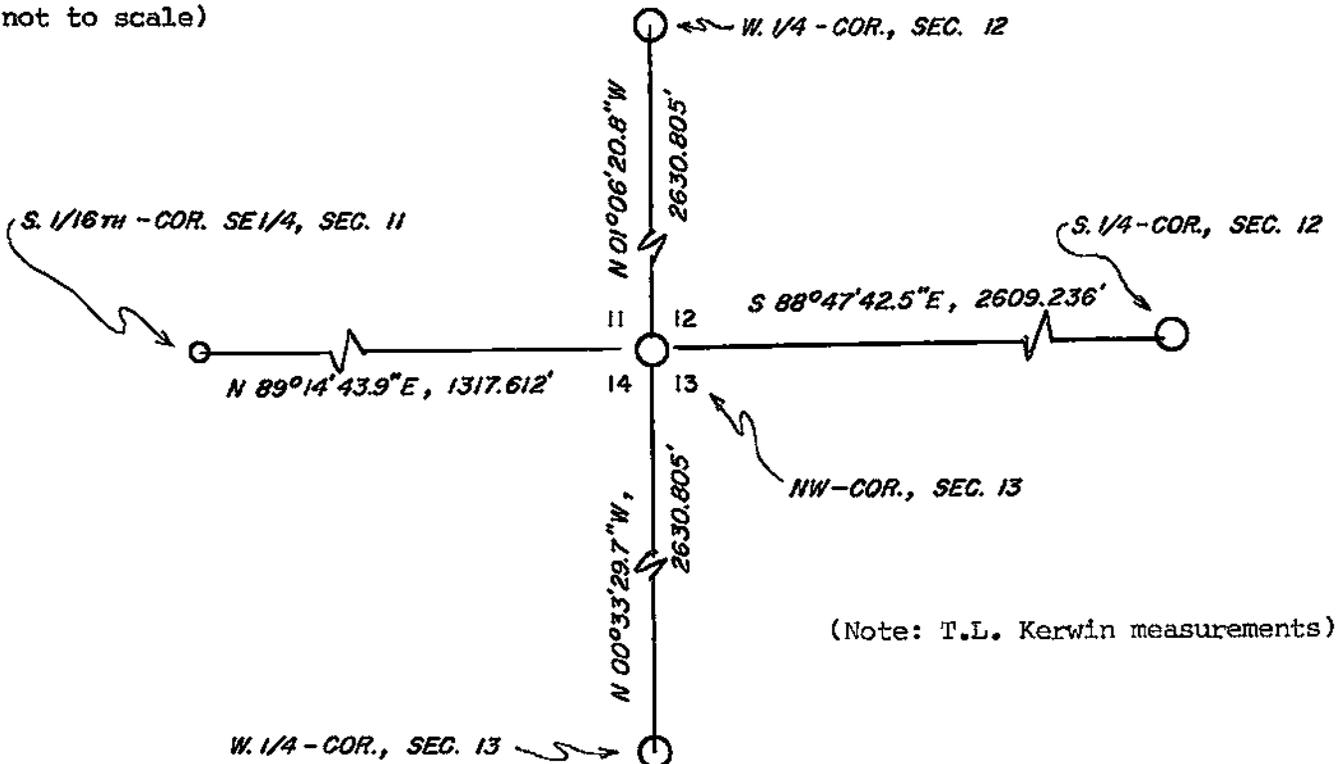

I, William C. Jung, County Surveyor
 HEREBY CERTIFY THAT THE CORNER LOCATION SHOWN ON THIS RECORD
 WAS DETERMINED BY ME OR UNDER MY DIRECTION AND CONTROL AND
 THAT THIS U. S. PUBLIC LAND SURVEY MONUMENT RECORD IS CORRECT
 AND COMPLETE TO THE BEST OF MY KNOWLEDGE AND BELIEF.

William C. Jung 12/29/93
 Signature Date

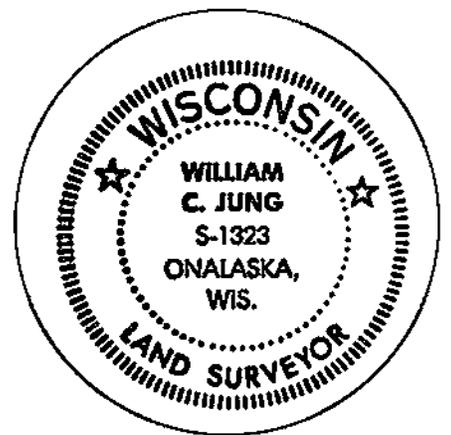

Seal