


U. S. PUBLIC LAND SURVEY MONUMENT RECORD

SECTION 12 T 18 N, R 8 W, TOWN OF HOLLAND
LA CROSSE COUNTY

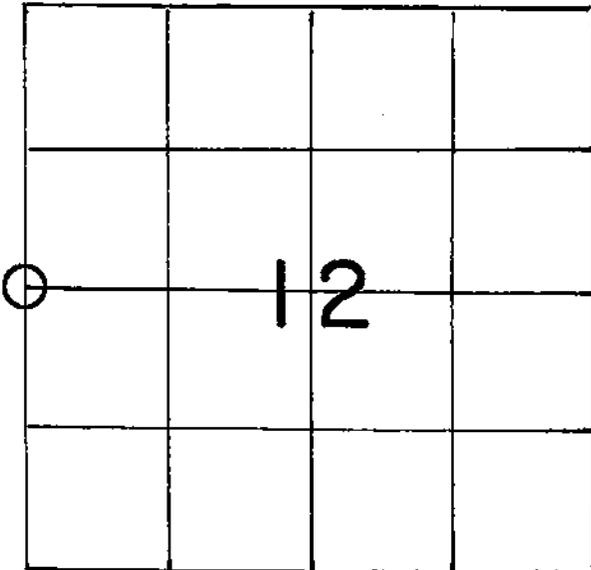

LOCATION OF LANDMARK

Crew: WILLIAM C. JUNG
PETER F. FOLLANSBEE

Date: 9/09/1993 and 3/23/07

Describe any record evidence, monument evidence, testimonial evidence or any other material evidence you considered and whether the monument was found or restored through acceptance of an obliterated evidence location.

I found an iron pipe at the corner which had been used in previous survey work as the quarter corner. I accepted this pipe as the best available evidence of the original government corner position. I did not set a Lunde marker because of the close proximity of underground utility lines.

3/23/07

Removed the pipe and replaced it with a Lunde marker. Buried a wine bottle with a shell casing with the marker.

Describe or show any material discrepancy between the location of the restored corner and that of the corner previously restored or reestablished.

None Known.

WISCONSIN COORDINATE SYSTEM

North

East

Theta Angle

Horiz. Order

Vert. Order


TYPE OF LANDMARK Lunde marker
~~Existing 1 1/4" Iron Pipe (O.D.)~~

BEARINGS ARE REFERENCED TO

Terry L. Kerwin's survey dated
5/28/90 located in the NW $\frac{1}{4}$ -NW $\frac{1}{4}$,
Section 13-18-8.


RECORD OF DURABLE WITNESS MONUMENTS

NO	DESCRIPTION	BEARING	DISTANCE
1	Existing 1" Iron Pipe west of Nail ②	West ±	4.03' W. of ②
2	Set Nail in NE-side 1 1/2" Cedar	West ±	23.88'
3	Fd. 1" Iron Pipe (O.D.)	Southwest ±	36.09'
4	metal bottom NW-Cor. of V of Tremp. Elect. Power Box	S 1/4 SW	34.31'

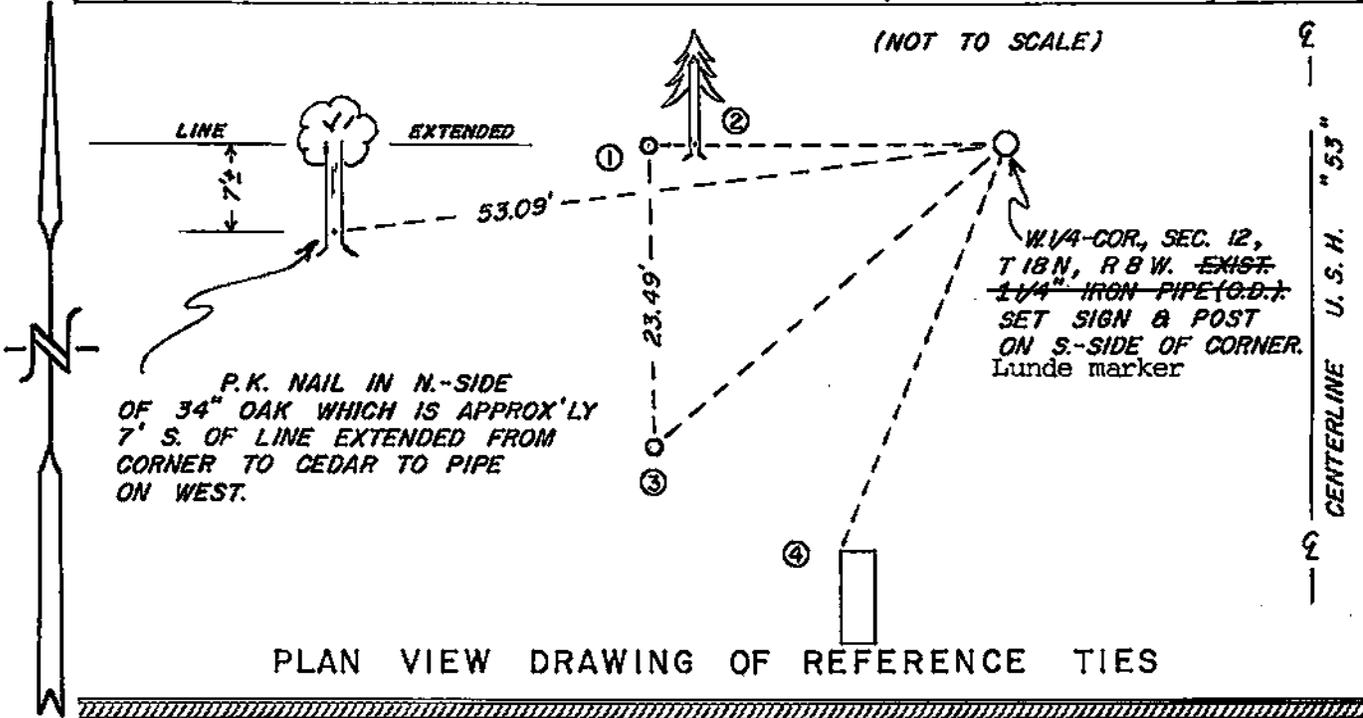

MAP SHOWING DISTANCE AND DIRECTION TO OTHER PUBLIC LAND SURVEY CORNERS USED FOR REESTABLISHING THE CORNER

(not to scale)

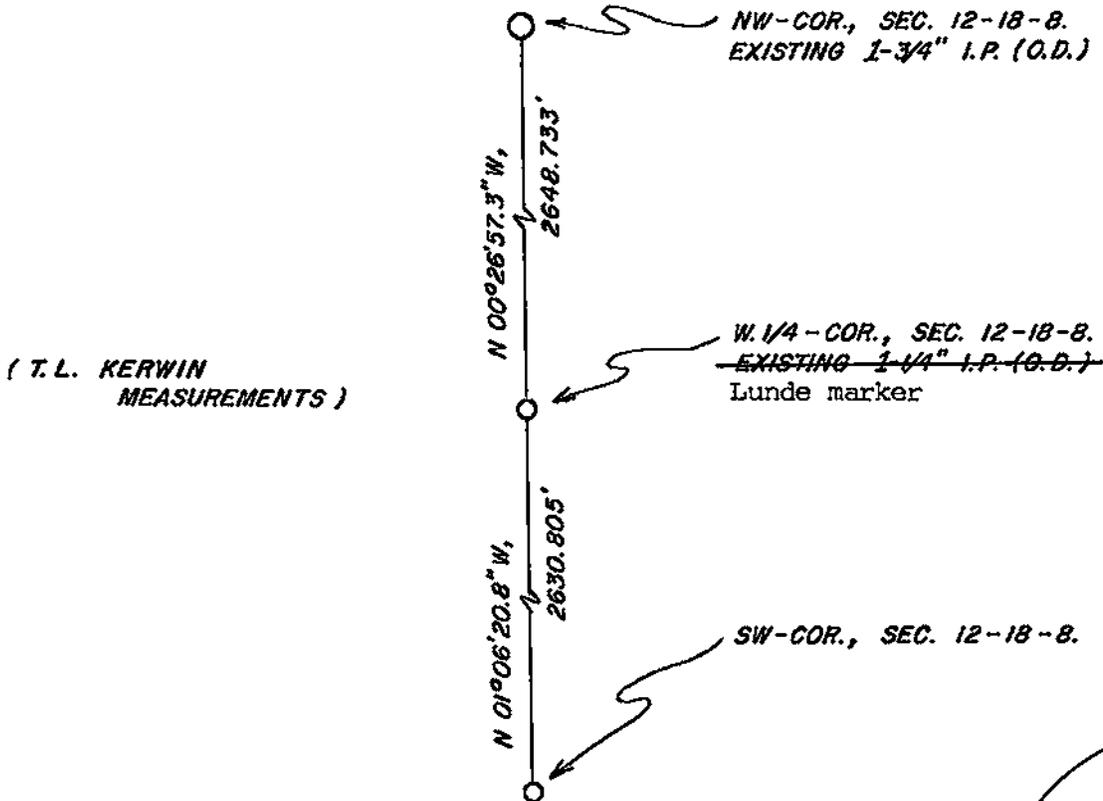


I, William C. Jung, County Surveyor
 HEREBY CERTIFY THAT THE CORNER LOCATION SHOWN ON THIS RECORD WAS DETERMINED BY ME OR UNDER MY DIRECTION AND CONTROL AND THAT THIS U. S. PUBLIC LAND SURVEY MONUMENT RECORD IS CORRECT AND COMPLETE TO THE BEST OF MY KNOWLEDGE AND BELIEF.

William C. Jung
 Signature

12/29/93
 Date

Revised: 7/19/07 *asej*

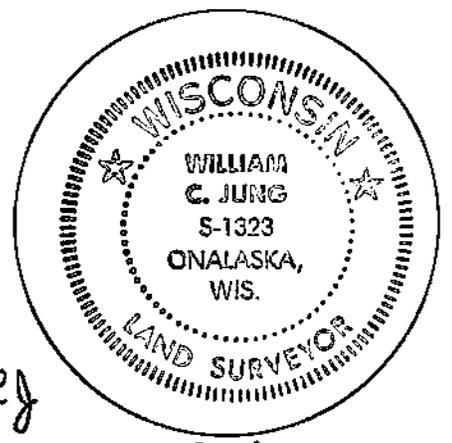

Seal