


U. S. PUBLIC LAND SURVEY MONUMENT RECORD

SECTION 13 T 18 N, R 8 W, TOWN OF HOLLAND

LA CROSSE COUNTY

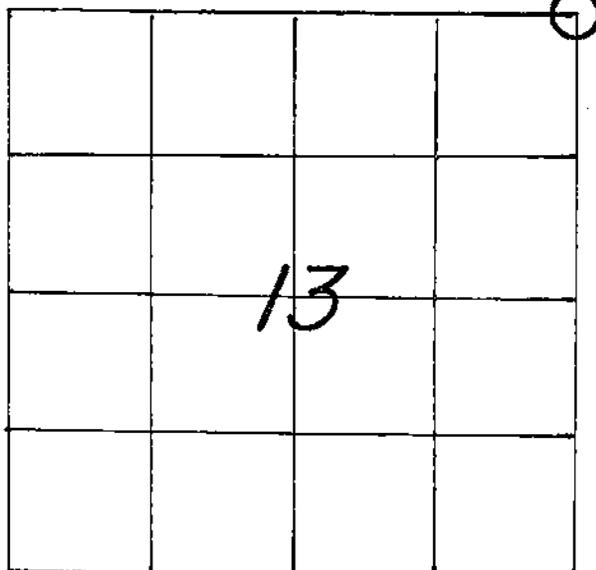

WISCONSIN COORDINATE SYSTEM

North

East

Theta Angle

Horiz. Order

Vert. Order

TYPE OF LANDMARK

1" (O.D.) IRON PIPE.

BEARINGS ARE REFERENCED TO

LOCATION OF LANDMARK

CREW: WILLIAM G. JUNG

PETER F. FOLLANSBEE

DATE: 1/02/2004


Describe any record evidence, monument evidence, testimonial evidence or any other material evidence you considered and whether the monument was found or restored through acceptance of an obliterated evidence location.

I found a pipe at the corner which had been used in several previous surveys of record. To the NW I found a stump hole for a long dead and 19" tree. The bearing & distance fit the call in the original notes. To the SW I found an old rotted 2' stump. The bearing and distance to this stump missed the original call by about 10 links. The distance in the original notes may be in error. I accepted the pipe as being at the original government corner location. Describe or show any material discrepancy between the location of the restored corner and that of the corner previously restored or reestablished.

NONE KNOWN.

RECORD OF DURABLE WITNESS MONUMENTS

NO	DESCRIPTION	MAGNETIC	
		BEARING	DISTANCE
1	SET A NAIL IN S.-SIDE OF AN 11-1/2" WHITE OAK	N 86° W	52.68 FT.
2	SET A NAIL IN N.W.-SIDE OF A 12" WHITE OAK	N 26° E	45.92 FT.
3	SET A NAIL IN N.-SIDE OF A 12-1/2" WHITE OAK	N 89° E	53.56 FT.
4	SET A NAIL IN S.W.-SIDE OF A 19" OAK	S 37° E	39.93 FT.

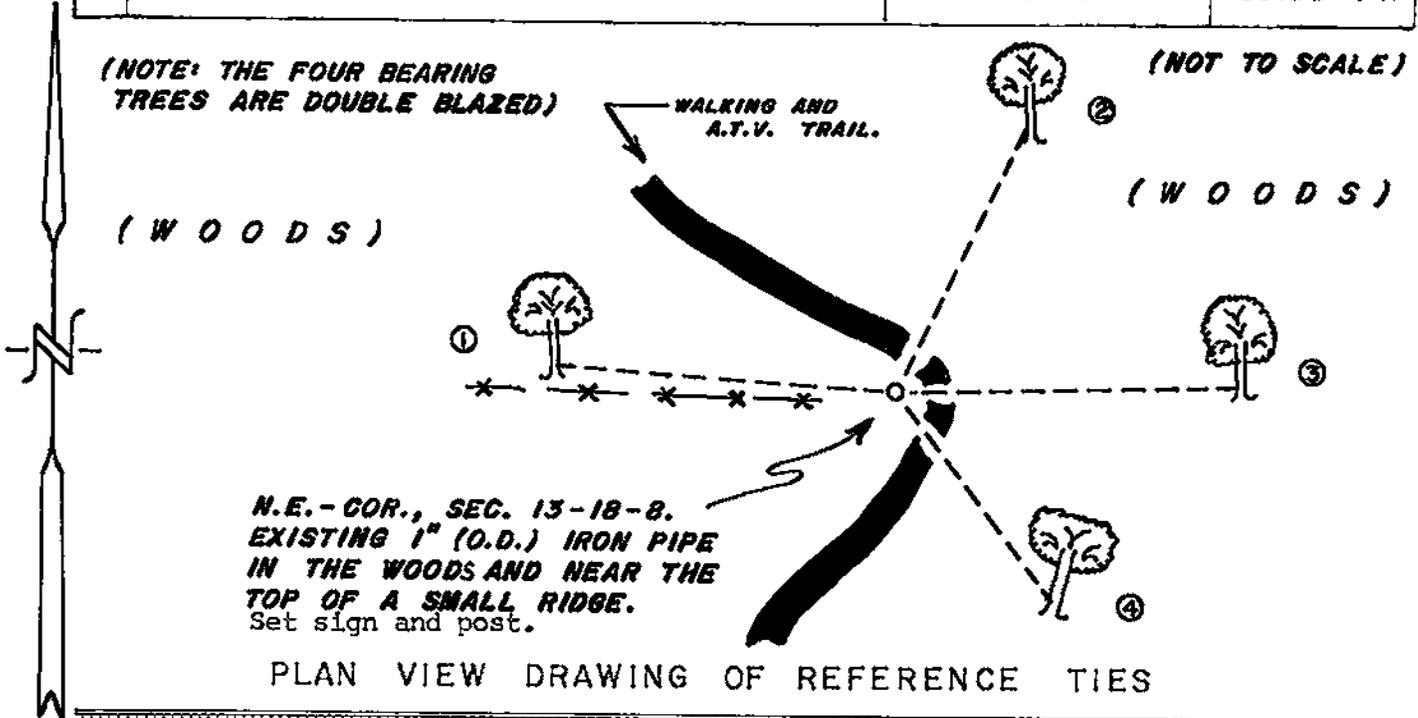

MAP SHOWING DISTANCE AND DIRECTION TO OTHER PUBLIC LAND SURVEY CORNERS USED FOR REESTABLISHING THE CORNER

No further section measurements were made by me at this time. I evaluated this corner based on section measurements of record.

I, WILLIAM C. JUNG, COUNTY SURVEYOR
 HEREBY CERTIFY THAT THE CORNER LOCATION SHOWN ON THIS RECORD
 WAS DETERMINED BY ME OR UNDER MY DIRECTION AND CONTROL AND
 THAT THIS U. S. PUBLIC LAND SURVEY MONUMENT RECORD IS CORRECT
 AND COMPLETE TO THE BEST OF MY KNOWLEDGE AND BELIEF.

William C. Jung 1/19/04
 Signature Date



Seal