


21808120020

## U. S. PUBLIC LAND SURVEY MONUMENT RECORD

SECTION 13 T 18 N, R 8 W, TOWN OF HOLLAND

LA CROSSE COUNTY

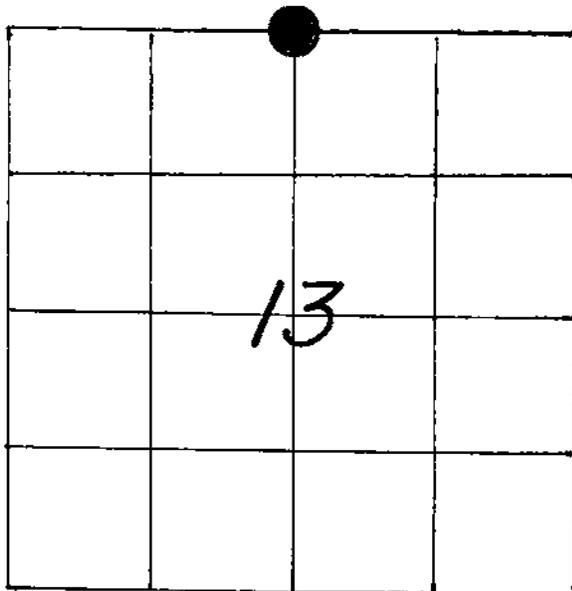

LOCATION OF LANDMARK

CREW: **WILLIAM C. JUNG**  
**PETER F. FOLLANSBEE**  
 DATE: **10/02/2003**

WISCONSIN COORDINATE SYSTEM

North

East

Theta Angle

Horiz. Order

Vert. Order

TYPE OF LANDMARK

**3/4" x 30" ROUND IRON BAR.**

BEARINGS ARE REFERENCED TO

LaCrosse County Coordinate System  
 as per Paul Fairchild measurements

Describe any record evidence, monument evidence, testimonial evidence or any other material evidence you considered and whether the monument was found or restored through acceptance of an obliterated evidence location.

In 1990 Terry Kerwin completed section survey work in Sections 12 and 13. He and I went over his section measurements and agreed to the final locations of the government corners including this 1/4 corner. Paul Fairchild spotted a single proportionate position for me. We then monumented this position with an iron bar. The bar is within 0.2' of where Terry and I had agreed to set the corner. The bar fits the old occupation to the South and the surveys completed since 1990. Describe or show any material discrepancy between the location of the restored corner and that of the corner previously restored or reestablished.

**NONE KNOWN.**

