


U. S. PUBLIC LAND SURVEY MONUMENT RECORD

SECTION 13 T 18 N, R 8 W, TOWN OF HOLLAND

LA CROSSE COUNTY

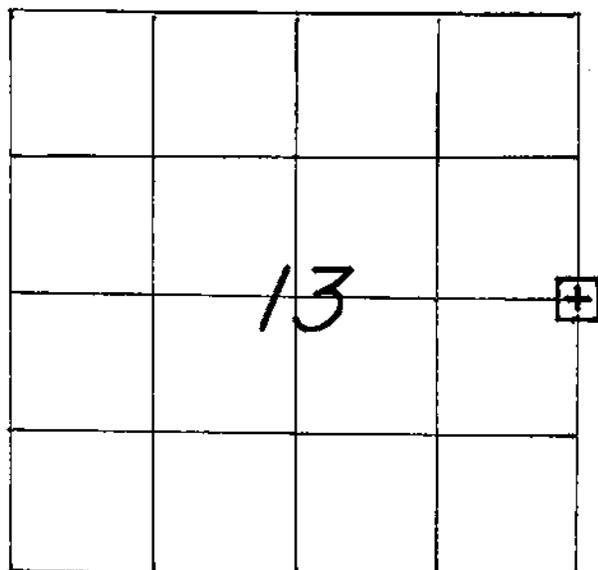

LOCATION OF LANDMARK

CREW: WILLIAM C. JUNG
 PETER F. FOLLANSBEE
 DATE: 1/02/2004

Crew: William C. Jung
 Date: 10/5/04

WISCONSIN COORDINATE SYSTEM

North

East

Theta Angle

Horiz. Order

Vert. Order

TYPE OF LANDMARK Iron bar with a cap
~~EXISTING 9" SQUARE STONE~~

BEARINGS ARE REFERENCED TO

Describe any record evidence, monument evidence, testimonial evidence or any other material evidence you considered and whether the monument was found or restored through acceptance of an obliterated evidence location.

I found a stone at the old occupied corner. The stone had a large "+" on it.

The stone may have been set by VanLoon when he was working in this area in 1930. I accepted the stone and occupied corner as the best available evidence of the original government corner location.


10/5/04 - I removed the stone (which varied from 2" to 4" thick) and replaced it with a 3/4"x30" iron bar with an aluminum Berntsen cap.

Describe or show any material discrepancy between the location of the restored corner and that of the corner previously restored or reestablished.

About S77.5°E, 9.48 feet is a pipe that had been used as the corner in previous survey work. I do not believe that this pipe should be accepted as the corner.

RECORD OF DURABLE WITNESS MONUMENTS

NO	DESCRIPTION	MAGNETIC	
		BEARING	DISTANCE
1	SET A NAIL IN N.W.-SIDE OF A 19" OAK	S 7 1/2° W	14.27 FT.
2	SET A NAIL IN N.W.-SIDE OF A 21" OAK	S 65° W	18.51 FT.
3	SET A NAIL IN S.W.-SIDE OF AN 18-1/2" ASPEN	N 44° W	15.00 FT.
4	EX. 1-3/4" (O.D.) IRON PIPE, UP 4" AND S. OF FENCE	S 77 1/2° E	9.48 FT.

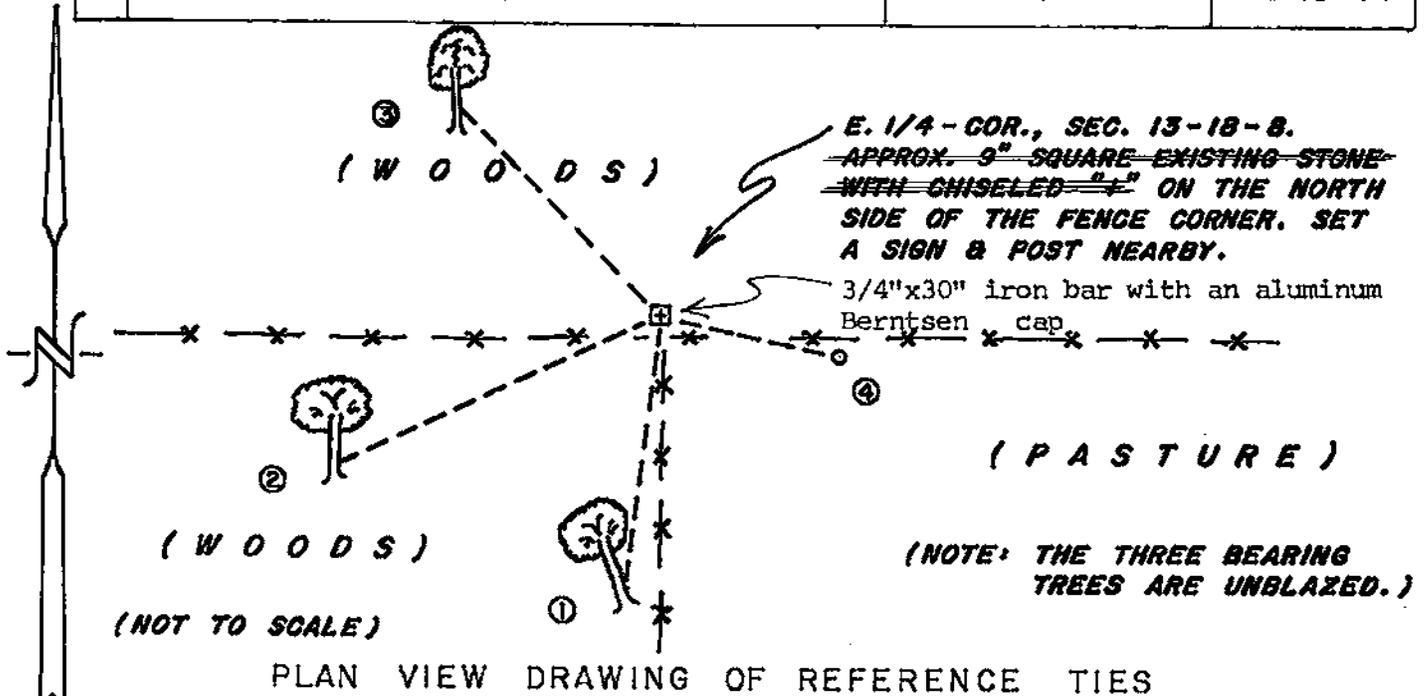

MAP SHOWING DISTANCE AND DIRECTION TO OTHER PUBLIC LAND SURVEY CORNERS USED FOR REESTABLISHING THE CORNER

No further section measurements were made by me at this time. I evaluated this corner based on section measurements of record.

I, WILLIAM C. JUNG, COUNTY SURVEYOR
 HEREBY CERTIFY THAT THE CORNER LOCATION SHOWN ON THIS RECORD WAS DETERMINED BY ME OR UNDER MY DIRECTION AND CONTROL AND THAT THIS U. S. PUBLIC LAND SURVEY MONUMENT RECORD IS CORRECT AND COMPLETE TO THE BEST OF MY KNOWLEDGE AND BELIEF.

William C. Jung 1/19/04
 Signature Date

Revised: 1/24/05

wcj



Seal