


21808140020

U. S. PUBLIC LAND SURVEY MONUMENT RECORD

SECTION 14 T 18 N, R 8 W, TOWN OF HOLLAND

LA CROSSE COUNTY

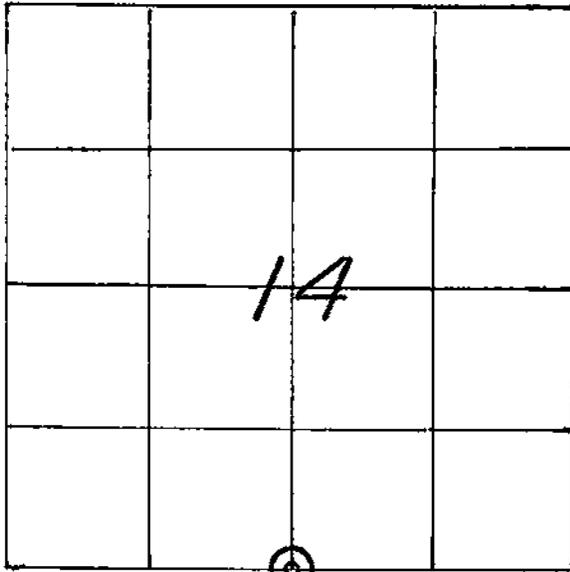

LOCATION OF LANDMARK

CREW: WILLIAM C. JUNG
 PETER F. FOLLANSBEE
 DATE: 7/24/1997

WISCONSIN COORDINATE SYSTEM

North

East

Theta Angle

Horiz. Order

Vert. Order

TYPE OF LANDMARK

EXISTING P.K. NAIL.

BEARINGS ARE REFERENCED TO

Assumed

Describe any record evidence, monument evidence, testimonial evidence or any other material evidence you considered and whether the monument was found or restored through acceptance of an obliterated evidence location.


There was an iron pipe at this corner location that had been used in several surveys. Apparently this pipe had been knocked^{out} when the road was repaved. Scholze set this P.K. nail at the old location of the pipe. I accepted this location as the best available evidence of the original government corner position.

Describe or show any material discrepancy between the location of the restored corner and that of the corner previously restored or reestablished.

NONE KNOWN.

RECORD OF DURABLE WITNESS MONUMENTS
ASSUMED

NO	DESCRIPTION	BEARING	DISTANCE
1	EXISTING IRON PIPE IN THE PAVEMENT OF GARFIELD RD.	N 00°07'14" E	1306.49 FT.
2	SET NAIL IN PAVEMENT	N 45°38'52" E	40.03 FT.
3	EXISTING P.K. NAIL IN THE PAVEMENT AMSTERDAM PR. RD.	N 89°36'02" E	2636.40 FT.
4	SET 1-5/8" x 29" IRON PIPE IN THE FENCE TO THE SOUTH	S 01°53'41" E	32.95 FT.

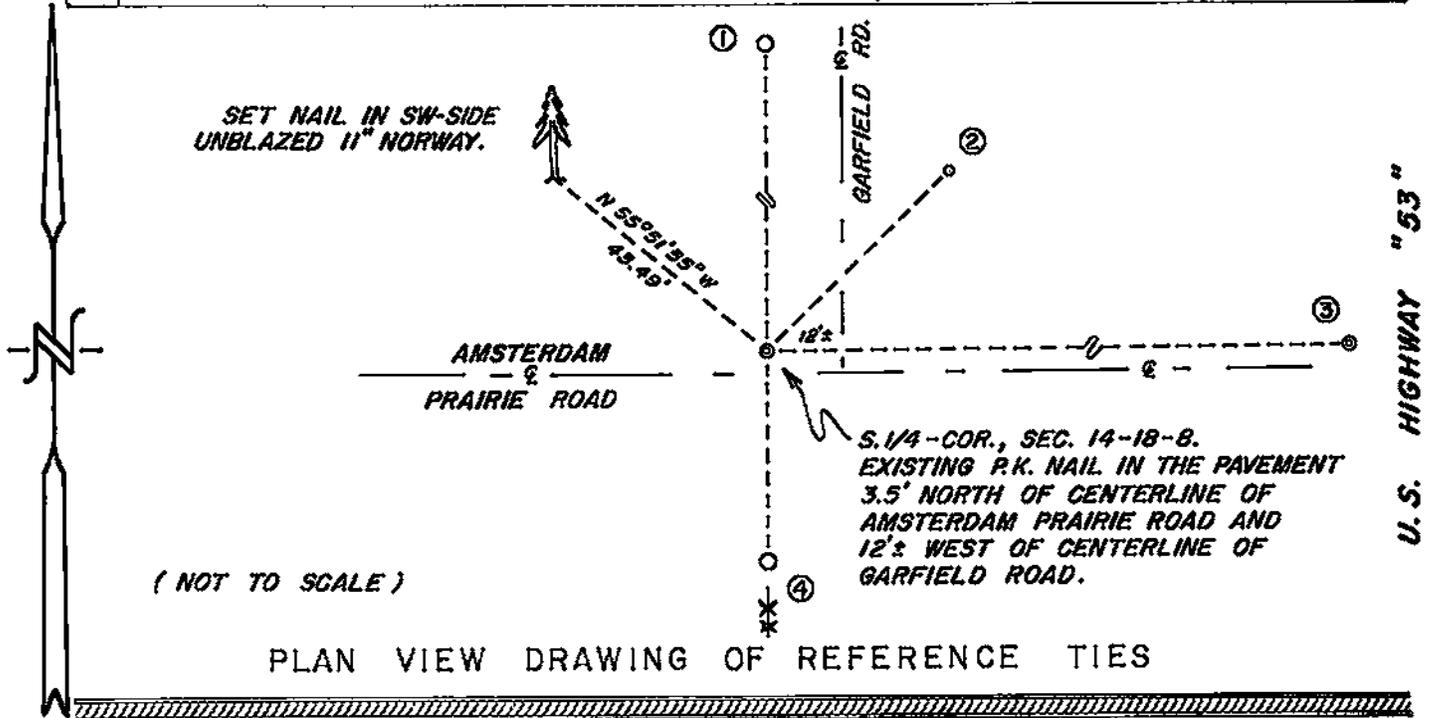


MAP SHOWING DISTANCE AND DIRECTION TO OTHER PUBLIC LAND SURVEY CORNERS USED FOR REESTABLISHING THE CORNER

No section measurements were made by me at this time. The location of this corner was confirmed by others through previous survey work.

I, WILLIAM C. JUNG, COUNTY SURVEYOR
HEREBY CERTIFY THAT THE CORNER LOCATION SHOWN ON THIS RECORD WAS DETERMINED BY ME OR UNDER MY DIRECTION AND CONTROL AND THAT THIS U. S. PUBLIC LAND SURVEY MONUMENT RECORD IS CORRECT AND COMPLETE TO THE BEST OF MY KNOWLEDGE AND BELIEF.

William C. Jung 1/21/98
Signature Date

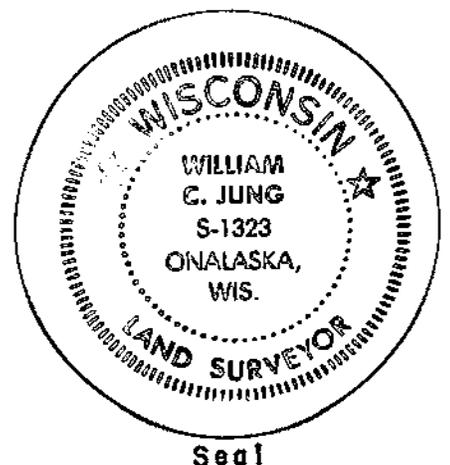

Seal