


U. S. PUBLIC LAND SURVEY MONUMENT RECORD

SECTION 13 T 18 N, R 8 W, TOWN OF HOLLAND
LA CROSSE COUNTY

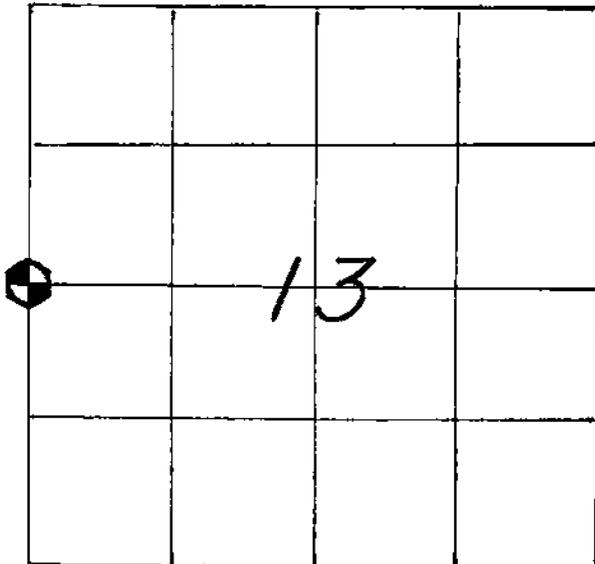

WISCONSIN COORDINATE SYSTEM

North

East

Theta Angle

Horiz. Order

Vert. Order

TYPE OF LANDMARK

BRASS CAP LUNDE MARKER.

BEARINGS ARE REFERENCED TO

LOCATION OF LANDMARK

CREW: WILLIAM C. JUNG
PETER F. FOLLANSBEE
DATE: 6/16/1998

Describe any record evidence, monument evidence, testimonial evidence or any other material evidence you considered and whether the monument was found or restored through acceptance of an obliterated evidence location.


I found an iron pipe at this corner that had been used as the corner in many previous surveys. I accepted it as the best available evidence of the original government corner position. I removed the iron pipe and replaced it with a brass capped Lunde marker.

Describe or show any material discrepancy between the location of the restored corner and that of the corner previously restored or reestablished.

NONE KNOWN.

RECORD OF DURABLE WITNESS MONUMENTS
MAGNETIC

NO	DESCRIPTION	BEARING	DISTANCE
1	SET A NAIL IN N-SIDE 13" TRUNK OF A TRIPLE OAK	WEST ±	64.38 FT.
2	SET A NAIL IN N.E.-SIDE OF A 6" OAK	N 83° W	71.11 FT.
3	SET A NAIL IN E.-SIDE OF A 6" ELM	N 25° W	39.90 FT.
4	SET A NAIL IN S-SIDE OF THE CENTER TRUNK-TRIPLE ELM	N 16° W	51.16 FT.

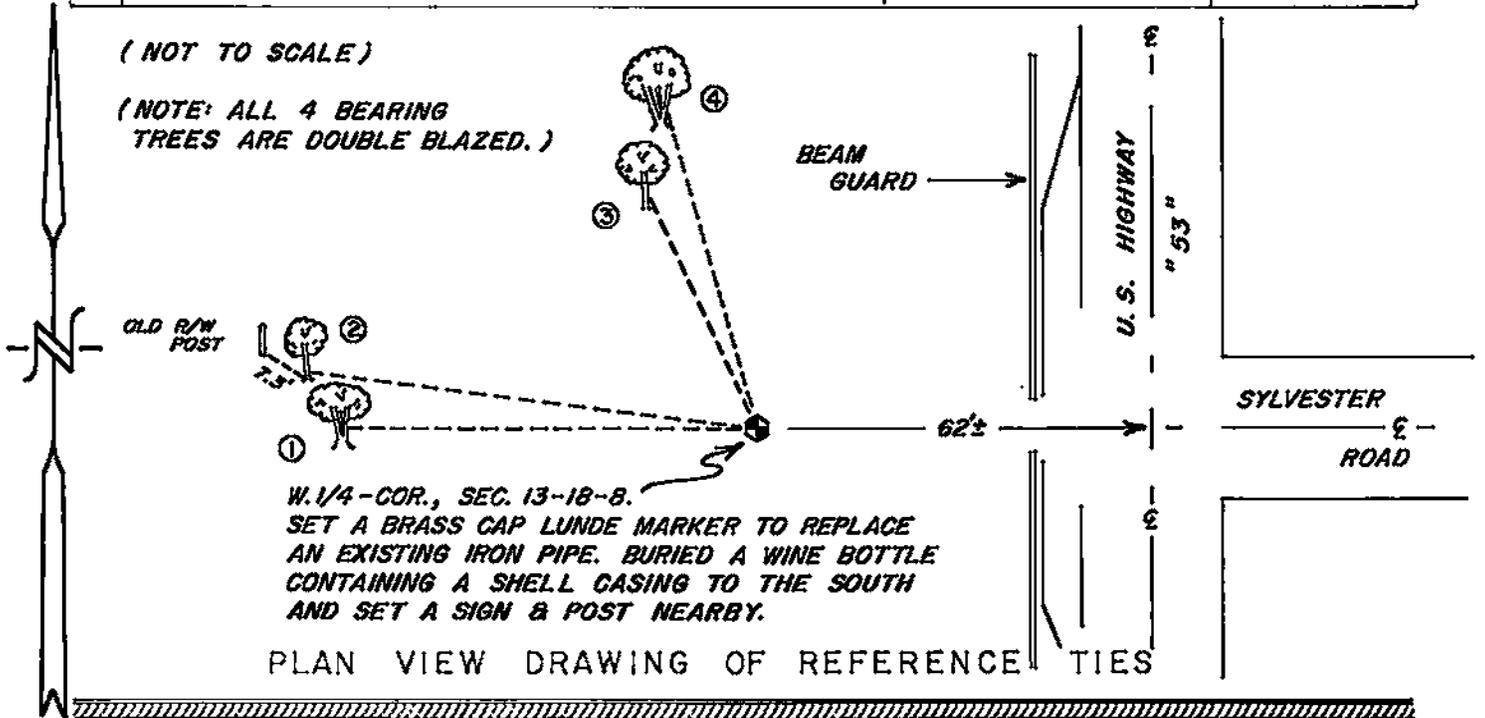


MAP SHOWING DISTANCE AND DIRECTION TO OTHER PUBLIC LAND SURVEY CORNERS USED FOR REESTABLISHING THE CORNER

No further section measurements were made by me at this time. The location of this corner had been confirmed by previous section data of record.

I, WILLIAM C. JUNG, COUNTY SURVEYOR
HEREBY CERTIFY THAT THE CORNER LOCATION SHOWN ON THIS RECORD WAS DETERMINED BY ME OR UNDER MY DIRECTION AND CONTROL AND THAT THIS U. S. PUBLIC LAND SURVEY MONUMENT RECORD IS CORRECT AND COMPLETE TO THE BEST OF MY KNOWLEDGE AND BELIEF.

William C. Jung
Signature

8/26/98
Date

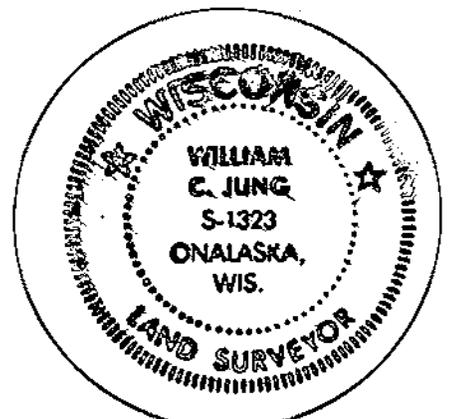

Seal