

LA CROSSE COUNTY


U.S. PUBLIC LAND SURVEY MONUMENT RECORD

SECTION Corner common to Sections 15, 16, 21 & 22

T. 18 N., R. 8 W.

Type of monument 7/8" X60" REBAR

Location indicated on sketch --  --

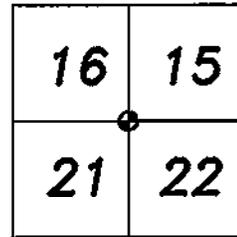


Location Sketch

Describe any record evidence, monument evidence, occupational evidence, testimonial evidence or any other material evidence you considered, and whether the monument was found or placed.

ORIGINAL GOVERNMENT ACCESSORIES WERE SEARCHED FOR, BUT NOTHING WAS FOUND. OTHER MONUMENT EVIDENCE WAS SEARCHED FOR, AND A 7" X12" X12" STONE WAS FOUND, APPROXIMATELY 3" BELOW THE SURFACE IN A SWAMP, AT THE APPROXIMATE INTERSECTION OF VERY REMNANT, CROOKED FENCE LINES NORTH AND WEST. ALSO FOUND U.S.E.O. SOUTHEAST BEARING TREE, NOW A VERY ROTTEN STUMP IN THE SWAMP. IN A 1928 SURVEY BY W. VAN LOON, A STONE IS CALLED TO BE AT THIS CORNER. W. VAN LOON ALSO SHOWS A TOWER 900 FEET SOUTH AND 14 FEET WEST OF THIS CORNER. REMAINS OF THIS TOWER WERE FOUND, WHICH CONSIST OF FOUR, ANGLE IRON POSTS APPROXIMATELY 3" BELOW THE SURFACE OF THE SWAMP. AN ANGLE IRON WAS ALSO FOUND NEAR THE SOUTHEAST CORNER OF THE NORTHEAST 1/4 OF THE NORTHEAST 1/4 OF SECTION 21-18-8. THE NORTHEAST CORNER OF THIS TOWER WAS FOUND TO BE 900.8 FEET SOUTH OF THE FOUND STONE AND 13.9 FEET WEST OF THE LINE FROM THE FOUND STONE TO THE FOUND ANGLE IRON, MATCHING EXTREMELY WELL WITH W. VAN LOON SURVEY. FOUND STONE ALSO MATCHES U.S.E.O. MATHEMATICAL POSITION VERY WELL. THIS POSITION MATCHES ORIGINAL GOVERNMENT DISTANCE TO THE NORTH QUARTER CORNER OF SECTION 21-18-8 BY LESS THAN 8 FEET. IT MATCHES ORIGINAL GOVERNMENT DISTANCE TO THE EAST QUARTER CORNER OF SECTION 16-18-8 BY LESS THAN 3 FEET. IT ALSO MATCHES THE "DOUBLE OVER" OF LINE AND DISTANCE FROM THE SOUTHEAST CORNER OF SECTION 21-18-8 AND A RETRACED POSITION OF U.S.E.O. CALLS FOR A FENCE INTERSECTION AT THE EAST QUARTER CORNER OF SECTION 21-18-8 BY LESS THAN 1 FOOT NORTH/SOUTH AND BY LESS THAN 6 FEET EAST/WEST. THEREFORE, BELIEVING FOUND STONE, AS DESCRIBED, TO BE THE BEST AVAILABLE EVIDENCE OF THIS CORNER'S ORIGINAL LOCATION, A 7/8" X60" REBAR WAS SET AND REFERENCED AS SHOWN BELOW.

Show a plan view drawing depicting the relevant monuments, providing reference ties to at least 4 witness monuments. Describe witness monuments. Show relationship to occupation.

o SET 5/8" X24" REBAR WITH PLASTIC CAP

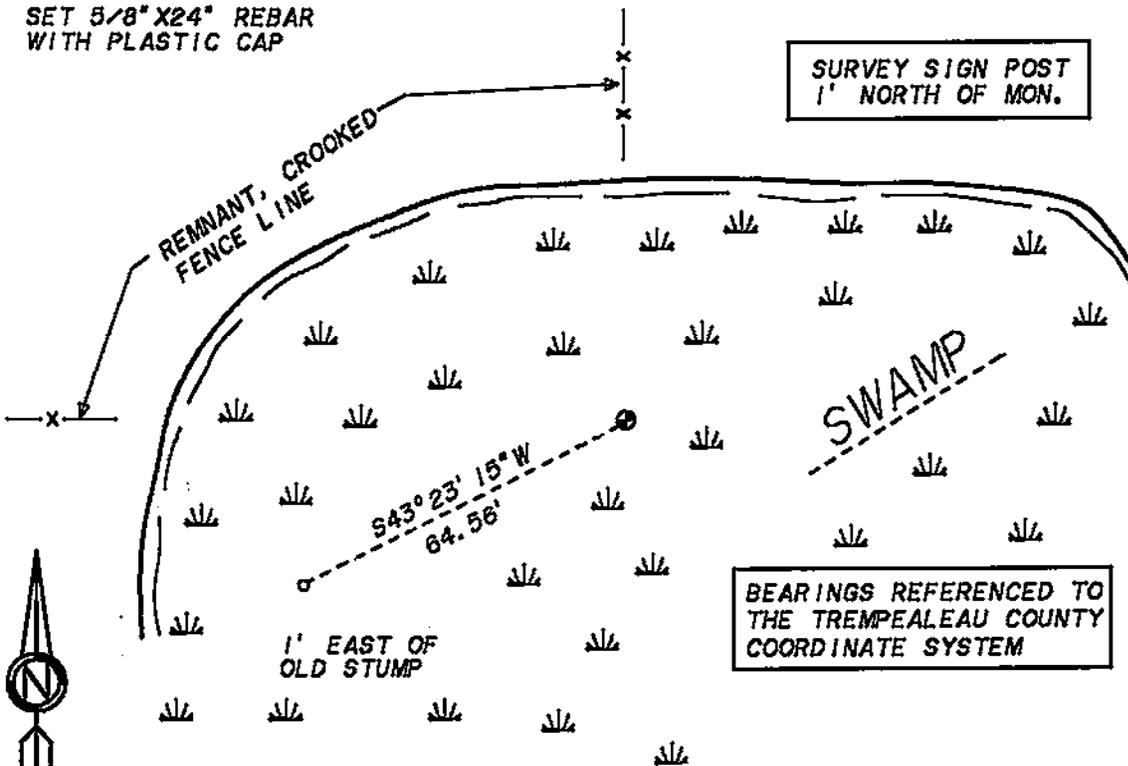

SURVEY SIGN POST
1' NORTH OF MON.

BEARINGS REFERENCED TO
THE TREMPLEALEU COUNTY
COORDINATE SYSTEM



no scale

Corner Identifier number 72-312

Describe any material discrepancy between the location of the corner as restored or reestablished and the location of that corner as previously restored or reestablished by distance and direction. Show the discrepancy on the plan view drawing. Show the distances between the corner as restored or reestablished, and (1) the corner as restored or reestablished, and (2) to at least 2 of the witness monuments shown on the drawing.

NO MATERIAL DISCREPANCY WAS FOUND.

Was the corner restored through acceptance of (1) an obliterated evidence location, (2) a found perpetuated location, or (3) an existent corner location?

A FOUND PERPETUATED LOCATION.

Was the corner reestablished through lost corner proportionate methods? If so, show the method including the directions and distances to other public land survey corners used as evidence or used for proportioning in determining the corner location.

NO.

Show the corner history of record in chronological order from Original Government Survey to present.

**ORIGINAL GOVERNMENT SURVEY - CYRUS WOODWORTH - SEPTEMBER 1847
SET POST CORNER TO SECTIONS. MARKED TWO BEARING TREES.**

**LA CROSSE COUNTY OLD SURVEY RECORDS - W. VAN LOON - DECEMBER 1928
SURVEYS LINES LOCATED IN SECTION 22-18-8. NOTES INDICATE A STONE AT THE
NORTHWEST CORNER OF SECTION 22. ALSO SHOWS A TOWER SOUTH OF THIS CORNER.**

**UNITED STATES ENGINEER OFFICE - WIELDE - JULY 1932
SURVEYS FOR THE LOCK AND DAM SYSTEM ALONG THE MISSISSIPPI RIVER. NOTES
CALL FOR A FOUND ROCK AT FENCE INTERSECTION OF FENCE LINES NORTH AND
EAST/WEST. ROCK CLAIMED BY FARMER TO BE AT SECTION CORNER. MARKED TWO
BEARING TREES.**

I, JOSEPH P. NELSEN
certify that the corner location shown on this record
was determined by me or under my direction and control
and that this U.S. Public Land Survey Monument Record
is correct to the best of my knowledge and belief.

Joseph P. Nelsen 9-21-99
Signature Date

Affix Land Surveyor Seal

