

LA CROSSE COUNTY


U.S. PUBLIC LAND SURVEY MONUMENT RECORD

QUARTER Corner common to Sections 16 & 16

T. 18 N., R. 8 W.

Type of monument NO MONUMENT SET

Location indicated on sketch -  -

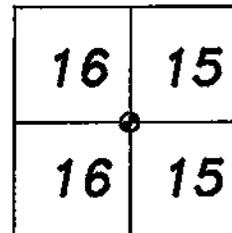

Location Sketch

Describe any record evidence, monument evidence, occupational evidence, testimonial evidence or any other material evidence you considered, and whether the monument was found or placed.

THIS CORNER LOCATION FALLS IN FLOOD PRONE BACK WATERS OF THE BLACK RIVER. IT IS BELIEVED THAT ANY EVIDENCE OF THE ORIGINAL GOVERNMENT MONUMENT OR BEARING TREES HAS LONG SINCE BEEN LOST TO NEARLY ANNUAL FLOODWATERS. A VERY, WELL ESTABLISHED, STRAIGHT FENCE LINE WAS FOUND ALONG THE EAST/WEST QUARTER LINE OF SECTION 16-18-8. LOCAL LAND OWNERS HAVE INDICATED THAT THIS FENCE LINE HAS ALWAYS BEEN CONSIDERED AS BEING LOCATED ON THE EAST/WEST QUARTER LINE OF SECTION 16-18-8. ORTHOPHOTOGRAPHY OF THIS AREA, COMPILED IN THE EARLY 1970S, DOES NOT SHOW ANY OCCUPATIONAL EVIDENCE AT THIS CORNER LOCATION. THE NORTH/SOUTH POSITION OF THIS CORNER WAS RESTORED BY HOLDING THE EASTERLY PROJECTION OF THE EAST/WEST FENCE LINE FOUND ALONG THE EAST/WEST QUARTER LINE OF SECTION 16-18-8. THE EAST/WEST POSITION OF THIS CORNER WAS REESTABLISHED BY HOLDING LINE BETWEEN THE NORTHEAST AND SOUTHEAST CORNERS OF SECTION 16-18-8. THIS POSITION MATCHES ORIGINAL GOVERNMENT DISTANCE TO THE SOUTHEAST CORNER OF SECTION 16-18-8 BY LESS THAN 3 FEET. THEREFORE, BELIEVING THIS POSITION, AS DESCRIBED, TO BE THE BEST AVAILABLE EVIDENCE OF THIS CORNER'S ORIGINAL LOCATION, A COMPUTED POSITION WAS DOCUMENTED AS INDICATED ON THIS SHEET.

Show a plan view drawing depicting the relevant monuments, providing reference ties to at least 4 witness monuments. Describe witness monuments. Show relationship to occupation.

NO MONUMENT WAS SET. POSITION LOCATED IN SWAMPY BACK WATER OF THE BLACK RIVER. PLEASE REFER TO SECTION DATA SHEETS ON FILE AT THE COUNTY SURVEYOR'S OFFICE FOR COORDINATE POSITION OF THIS CORNER.

Corner identifier number

72-308



no scale

