

21808172000

TREMPEALEAU COUNTY


U.S. PUBLIC LAND SURVEY MONUMENT RECORD

QUARTER Corner common to Sections 16 & 17

T. 18 N., R. 8 W.

Type of monument 7/8" X30" REBAR WITH ALUMINUM CAP

Location indicated on sketch -  -

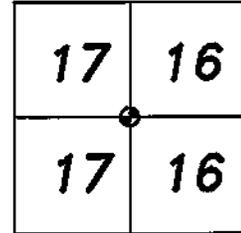


Location Sketch

Describe any record evidence, monument evidence, occupational evidence, testimonial evidence or any other material evidence you considered, and whether the monument was found or placed.

ORIGINAL GOVERNMENT ACCESSORIES WERE SEARCHED FOR, BUT NOTHING WAS FOUND. OTHER MONUMENT EVIDENCE WAS SEARCHED FOR, AND A 7/8" REBAR WAS FOUND BENT AND DISTURBED BELOW THE ROAD SURFACE. REBAR WAS SET BY R. CHALSMAN IN 1986, APPARENTLY AT THE INTERSECTION OF ROAD CENTERLINES NORTH/SOUTH AND WEST. DUE TO THIS CORNER POSITION BEING LOCATED IN AN EXISTING ROADBED, IT WAS EXCAVATED WITH BACK HOE IN SEARCH OF SUBSURFACE MONUMENT EVIDENCE. NO OTHER MONUMENT EVIDENCE WAS FOUND. THIS BENT REBAR WAS SPUN FOR POSITION. FOUND REBAR MATCHES ORIGINAL GOVERNMENT DISTANCE TO THE NORTHEAST CORNER OF SECTION 17-18-8 BY ABOUT 4 FEET. IT MATCHES ORIGINAL GOVERNMENT DISTANCE TO THE SOUTHEAST CORNER OF SECTION 17-18-8 BY LESS THAN 1 FOOT. IT ALSO MATCHES THE SINGLE PROPORTIONATE POSITION BETWEEN THE NORTHEAST AND SOUTHEAST CORNERS OF SECTION 17-18-8 BY LESS THAN 2 FEET NORTH/SOUTH AND BY LESS THAN 4 FEET EAST/WEST. THEREFORE, BELIEVING THIS POSITION, AS DESCRIBED, TO BE THE BEST AVAILABLE EVIDENCE OF THIS CORNER'S ORIGINAL LOCATION, A 7/8" X30" REBAR WAS SET IN PLACE OF FOUND BENT REBAR AND REFERENCED AS SHOWN BELOW.

Show a plan view drawing depicting the relevant monuments, providing reference ties to at least 4 witness monuments. Describe witness monuments. Show relationship to occupation.

- SET 5/8" X24" REBAR WITH PLASTIC CAP
- FOUND 1" IRON PIPE

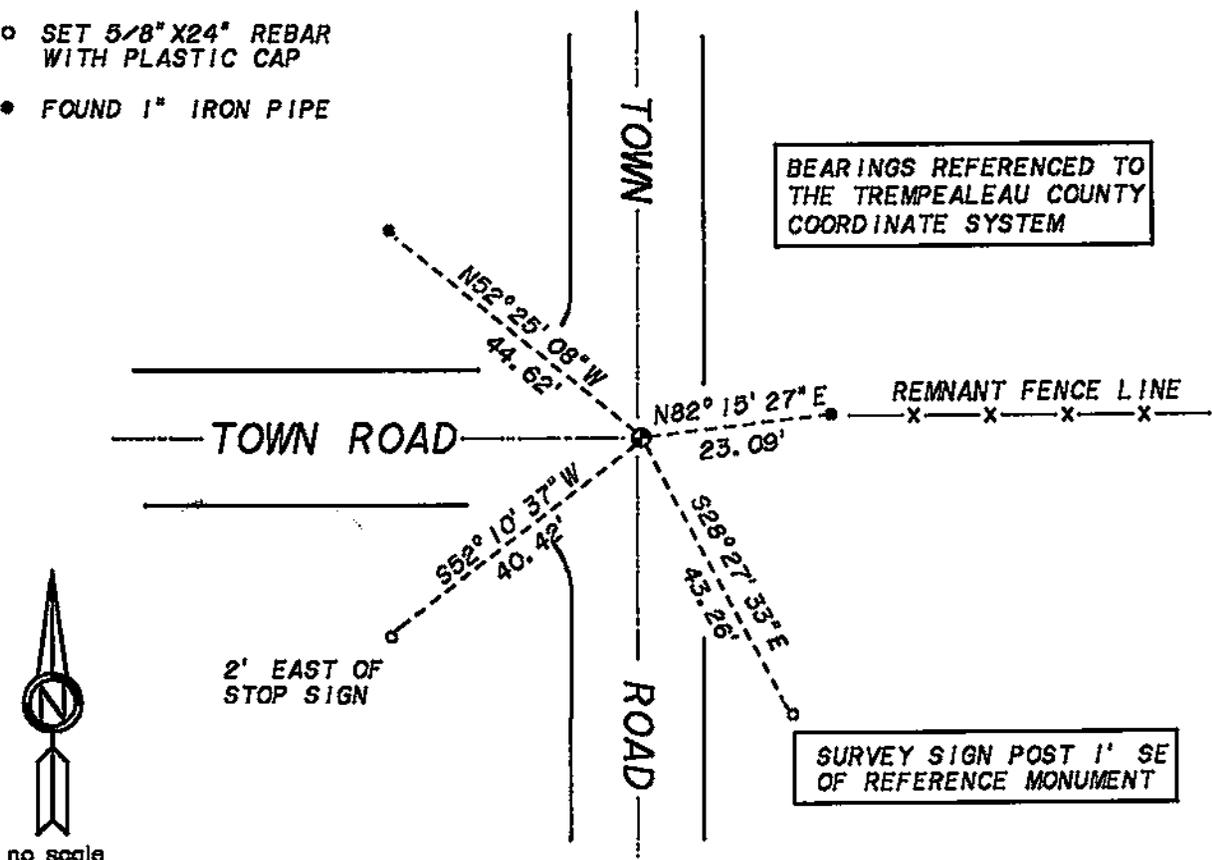

Corner Identifier number

80-308

Describe any material discrepancy between the location of the corner as restored or reestablished and the location of that corner as previously restored or reestablished by distance and direction. Show the discrepancy on the plan view drawing. Show the distances between the corner as restored or reestablished, and (1) the corner as restored or reestablished, and (2) to at least 2 of the witness monuments shown on the drawing.

NO MATERIAL DISCREPANCY WAS FOUND.

Was the corner restored through acceptance of (1) an obliterated evidence location, (2) a found perpetuated location, or (3) an existent corner location?

A FOUND PERPETUATED LOCATION.

Was the corner reestablished through lost corner proportionate methods? If so, show the method including the directions and distances to other public land survey corners used as evidence or used for proportioning in determining the corner location.

NO.

Show the corner history of record in chronological order from Original Government Survey to present.

**ORIGINAL GOVERNMENT SURVEY - CYRUS WOODWORTH - SEPTEMBER 1847
SET QUARTER SECTION POST. MARKED TWO BEARING TREES.**

**RECORD OF LAND CORNER PERPETUATION - R. CHALSMA - MAY 1986
FILES TIE SHEET FOR THE EAST QUARTER CORNER OF SECTION 17-18-8. CALLS FOR
A SET COUNTY MONUMENT. ALSO SETS FOUR REFERENCE MONUMENTS. INFORMATION
ON SHEET DOES NOT INDICATE SPECIFIC METHOD OF REESTABLISHMENT.**

**PRIVATE LAND SURVEYOR'S RECORDS - S. SOLBERG - DECEMBER 1986
SURVEYS PARCEL LOCATED IN SECTION 16-18-8. CALLS FOR A FOUND COUNTY
MARKER AT THE WEST QUARTER CORNER OF SECTION 16.**

**PRIVATE LAND SURVEYOR'S RECORDS - R. CHALSMA - JANUARY 1990
SURVEYS PARCEL LOCATED IN SECTION 17-18-8. CALLS FOR A FOUND COUNTY
MONUMENT AT THE EAST QUARTER CORNER OF SECTION 17.**

I, JOSEPH P. NELSEN
certify that the corner location shown on this record
was determined by me or under my direction and control
and that this U.S. Public Land Survey Monument Record
is correct to the best of my knowledge and belief.

Joseph P. Nelsen 9-21-99
Signature Date

Affix Land Surveyor Seal

