

2180820000

TREMPEALEAU COUNTY


U.S. PUBLIC LAND SURVEY MONUMENT RECORD

SECTION Corner common to Sections 20, 21, 28 & 29

T. 18 N., R. 8 W.

Type of monument 7/8" X30" REBAR WITH ALUMINUM CAP

Location indicated on sketch -- --

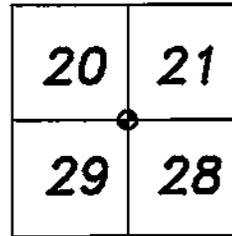


Location Sketch

Describe any record evidence, monument evidence, occupational evidence, testimonial evidence or any other material evidence you considered, and whether the monument was found or placed.

ORIGINAL GOVERNMENT ACCESSORIES WERE SEARCHED FOR, BUT NOTHING WAS FOUND. OTHER MONUMENT EVIDENCE WAS SEARCHED FOR, AND AN ALUMINUM CAPPED REBAR, AS CALLED FOR BY R. CHALSMAN IN 1986, WAS FOUND. ALSO FOUND ONE OF THE FOUR WITNESS MONUMENTS SET BY R. CHALSMAN. INFORMATION SHOWN ON THE SHEET FILED BY R. CHALSMAN DOES NOT SPECIFICALLY INDICATE HOW THIS CORNER POSITION WAS DETERMINED. DUE TO THIS, THE RESPONSIBLE SURVEY FIRM WAS CONTACTED AND INFORMATION WAS RECEIVED. THIS INFORMATION INDICATED THAT THIS CORNER POSITION WAS DETERMINED BY HOLDING A SINGLE PROPORTION POSITION BETWEEN THE NORTHEAST CORNER OF SECTION 20-18-8 AND THE SOUTHEAST CORNER OF SECTION 32-18-8. THIS MONUMENT WAS NOT FOUND AT THE INDICATED POSITION. THE MONUMENT WAS FOUND APPROXIMATELY 10 FEET SOUTH AND 11.5 FEET EAST OF THE POSITION INDICATED BY R. CHALSMAN DATA. IN 1932 THE U.S.E.O. TRAVERSED THE NORTH AND EAST LINES OF SECTION 20-18-8. ACCORDING TO U.S.E.O. SURVEY NOTES, A FENCE CORNER OF FENCES SOUTH AND WEST WAS FOUND. THE NOTES ALSO INDICATE A NEARBY HOUSE, WHICH WAS CLAIMED BY A FARMER, TO HAVE BEEN BUILT OVER THE SECTION CORNER. A FENCE LINE SOUTH AND THE EASTERLY PROJECTION OF A FENCE LINE FROM THE WEST WAS FOUND. THIS POSITION MATCHES U.S.E.O. POSITION OF A FOUND FENCE CORNER SOUTH AND WEST VERY WELL. A LOCAL LAND OWNER STATED THAT THE FENCE LINE TO THE WEST WAS ALWAYS CONSIDERED TO BE ON THE SECTION LINE, WHILE THE FENCE LINE TO THE SOUTH WAS CONSIDERED TO BE ON THE PROJECTED WESTERLY RIGHT OF WAY LINE OF THE TOWN ROAD TO THE SOUTH. THE LANDOWNER ALSO STATED THAT HE WAS NOT SURE HOW THE FOUND ALUMINUM CAPPED MONUMENT WAS PLACED, BUT DIDN'T THINK IT WAS CORRECT. A POSITION FOR THIS CORNER WAS DETERMINED BASED ON THE PROJECTION OF THE FENCE LINE FROM THE WEST HOLDING 33 FEET EAST OF THE FENCE LINE TO THE SOUTH, AS INDICATED BY THE LOCAL LAND OWNER. THIS POSITION MATCHES NORTH/SOUTH ROAD CENTERLINE APPROXIMATELY 1250 FEET SOUTH, BY ABOUT 4 FEET. IT MATCHES ORIGINAL GOVERNMENT DISTANCE TO THE NORTH QUARTER CORNER OF SECTION 20-18-8 BY LESS THAN 2 FEET. THE DISTANCE FROM THIS POSITION TO THE EAST QUARTER CORNER OF SECTION 20-18-8 IS NEARLY 33 FEET LONGER THAN ORIGINAL GOVERNMENT DISTANCE, POSSIBLY INDICATING A ONE CHAIN (2 POLE CHAIN) MISCOUNT BY THE ORIGINAL GOVERNMENT SURVEYORS. THEREFORE, BELIEVING THE PROCEDURE UTILIZED BY R. CHALSMAN IN 1986 TO BE AN INAPPROPRIATE METHOD OF REESTABLISHING THIS CORNER AND BELIEVING THE POSITION, AS DESCRIBED, TO BE THE BEST AVAILABLE EVIDENCE OF THIS CORNER'S ORIGINAL LOCATION, A 7/8" X30" REBAR WITH AN ALUMINUM CAP WAS SET AND REFERENCED AS SHOWN BELOW.

Show a plan view drawing depicting the relevant monuments, providing reference ties to at least 4 witness monuments. Describe witness monuments. Show relationship to occupation.

- o SET 5/8" X24" REBAR WITH PLASTIC CAP

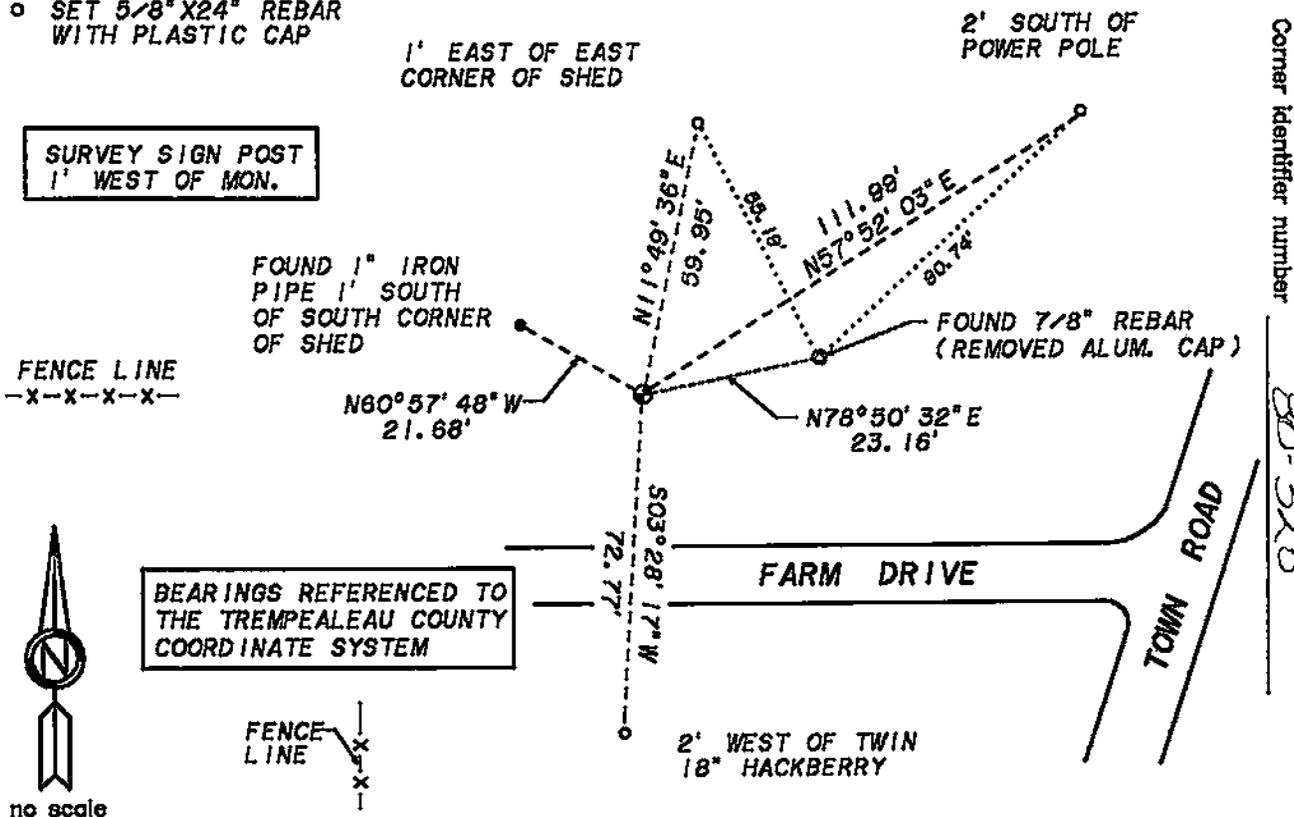

Describe any material discrepancy between the location of the corner as restored or reestablished and the location of that corner as previously restored or reestablished by distance and direction. Show the discrepancy on the plan view drawing. Show the distances between the corner as restored or reestablished, and (1) the corner as restored or reestablished, and (2) to at least 2 of the witness monuments shown on the drawing.

**MATERIAL DISCREPANCY AS FOLLOWS:
RESTORED CORNER TO FOUND 7/8" REBAR = N78°50'32"E, 23.16 FEET
(BEARING REFERENCED TO THE TREMPLEAU COUNTY COORDINATE SYSTEM)**

Was the corner restored through acceptance of (1) an obliterated evidence location, (2) a found perpetuated location, or (3) an existent corner location?

AN OBLITERATED EVIDENCE LOCATION.

Was the corner reestablished through lost corner proportionate methods? If so, show the method including the directions and distances to other public land survey corners used as evidence or used for proportioning in determining the corner location.

NO.

Show the corner history of record in chronological order from Original Government Survey to present.

**ORIGINAL GOVERNMENT SURVEY - CYRUS WOODWORTH - SEPTEMBER 1847
SET POST FOR SECTION CORNER. MARKED TWO BEARING TREES.**

**UNITED STATES ENGINEER OFFICE - L. JENSEN - JUNE 1932
SURVEYS FOR THE LOCK AND DAM SYSTEM ALONG THE MISSISSIPPI RIVER. NOTES
INDICATE A FENCE CORNER OF FENCES SOUTH AND WEST NEAR THE NORTHEAST
CORNER OF SECTION 20-18-8. NOTES ALSO INDICATE A HOUSE EASTERLY OF THE
FENCE CORNER THAT A FARMER CLAIMED WAS BUILT OVER THE SECTION CORNER.**

**PRIVATE LAND SURVEYOR'S RECORDS - C. SOLBERG - JUNE 1978
SURVEYS PARCEL IN SECTION 21-18-8. TIES SURVEY TO SOUTHWEST CORNER OF
SECTION 21. NO MENTION OF WHAT WAS FOUND OR SET.**

**CERTIFIED SURVEY MAP - R. CHALSMA - OCTOBER 1985
SURVEYS PARCELS IN SECTION 20-18-8. CALLS FOR 2" IRON PIPE SET AT THE
NORTHEAST CORNER OF SECTION 20.**

**RECORD OF LAND CORNER PERPETUATION - R. CHALSMA - OCTOBER 1986
FILES TIE SHEET FOR THE SOUTHEAST CORNER OF SECTION 20-18-8. CALLS FOR A
SET COUNTY MONUMENT. NO INFORMATION ON SHEET INDICATES SPECIFIC METHOD
OF REESTABLISHMENT.**

**PRIVATE LAND SURVEYOR'S RECORDS - S. SOLBERG - AUGUST 1993
SURVEYS PARCEL IN SECTION 20 & 20-18-8. CALLS FOR FOUND COUNTY MARKER AT
THE NORTHWEST CORNER OF SECTION 20.**

**CERTIFIED SURVEY MAPS - S. SOLBERG - APRIL 1994
FILES TWO CERTIFIED SURVEY MAP OF PARCELS IN SECTION 21-18-8. MAPS CALL
FOR FOUND COUNTY MARKER AT THE SOUTHWEST CORNER OF SECTION 21.**

Affix Land Surveyor Seal

I, JOSEPH P. NELSEN
certify that the corner location shown on this record
was determined by me or under my direction and control
and that this U.S. Public Land Survey Monument Record
is correct to the best of my knowledge and belief.

Joseph P. Nelsen 9-20-99
Signature Date

