

# TREMPEALEAU COUNTY


## U.S. PUBLIC LAND SURVEY MONUMENT RECORD

QUARTER Corner common to Sections 20 & 21

T. 18 N., R. 8 W.

Type of monument 7/8" X30" REBAR WITH ALUMINUM CAP

Location indicated on sketch - -

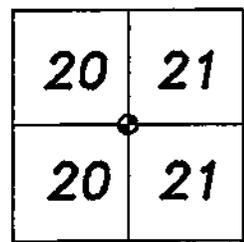

Location Sketch


Describe any record evidence, monument evidence, occupational evidence, testimonial evidence or any other material evidence you considered, and whether the monument was found or placed.

ORIGINAL GOVERNMENT ACCESSORIES WERE SEARCHED FOR, BUT NOTHING WAS FOUND. OTHER MONUMENT EVIDENCE WAS SEARCHED FOR AND AN ALUMINUM CAPPED REBAR, AS CALLED FOR R. CHALSMA IN 1985, WAS FOUND. ALSO FOUND THREE OF THE FOUR WITNESS MONUMENTS SET BY R. CHALSMA. REBAR WAS FOUND APPROXIMATELY ON A REMNANT FENCE LINE NORTH/SOUTH AND APPROXIMATELY 12 FEET SOUTH OF A REMNANT FENCE LINE EAST/WEST. INFORMATION SHOWN ON TIE SHEET DOES NOT SPECIFICALLY INDICATE HOW THIS CORNER POSITION WAS DETERMINED. DUE TO THIS, THE RESPONSIBLE SURVEY FIRM WAS CONTACTED AND INFORMATION WAS RECEIVED. THIS INFORMATION INDICATES THAT THIS POSITION MAY HAVE BEEN INTENDED TO BE SET AT SINGLE PROPORTIONATE MEASUREMENT BETWEEN THE SOUTHEAST CORNER OF SECTION 32-18-8 AND THE NORTHEAST CORNER OF SECTION 20-18-8. REBAR WAS FOUND 1.8 FEET NORTH AND 2.0 FEET WEST OF THE DESCRIBED SINGLE PROPORTION POSITION. IN 1932 THE U.S.E.O. TRAVERSED THE EAST LINE OF SECTION 20-18-8. THE NOTES INDICATE FINDING AN INTERSECTION OF NORTH/SOUTH AND EAST/WEST FENCE LINES AT THE EAST QUARTER CORNER OF SECTION 20-18-8. NOTES INDICATE THIS INTERSECTION AS POSSIBLE QUARTER CORNER. LOCAL LAND OWNER STATED THAT THIS FENCE INTERSECTION HAS ALWAYS BEEN CONSIDERED AS MARKING THE QUARTER CORNER LOCATION. HE ALSO STATED THAT HE THOUGHT THE EXISTING REBAR WAS SET WHERE IT IS BECAUSE THE SURVEYOR DIDN'T WANT TO CUT THROUGH THE BRUSH AT THE CORNER LOCATION. A POSITION FOR THIS CORNER WAS DETERMINED BASED ON OCCUPATION EVIDENCE, CONSISTING OF THE INTERSECTION OF REMNANT NORTH/SOUTH AND EAST/WEST FENCE LINES. THIS POSITION IS LOCATED APPROXIMATELY 12 FEET NORTHERLY OF THE EXISTING REBAR. THIS POSITION MATCHES LINE BETWEEN THE NORTHEAST AND SOUTHEAST CORNERS OF SECTION 20-18-8 BY LESS THAN 3 FEET. THE DISTANCE FROM THIS POSITION TO THE SOUTHEAST CORNER OF SECTION 20-18-8 IS NEARLY 33 FEET LONGER THAN ORIGINAL GOVERNMENT DISTANCE, POSSIBLY INDICATING A ONE CHAIN (2 POLE CHAIN) MISCOUNT BY THE ORIGINAL GOVERNMENT SURVEYORS. THEREFORE, BELIEVING THE PROCEDURE UTILIZED BY R. CHALSMA IN 1985 TO BE AN INAPPROPRIATE METHOD OF REESTABLISHING THIS CORNER, AND BELIEVING THIS POSITION, AS DESCRIBED, TO BE THE BEST AVAILABLE EVIDENCE OF THIS CORNER'S ORIGINAL LOCATION, A 7/8" X30" REBAR WITH AN ALUMINUM CAP WAS SET AND REFERENCED AS SHOWN BELOW.

Show a plan view drawing depicting the relevant monuments, providing reference ties to at least 4 witness monuments. Describe witness monuments. Show relationship to occupation.

- SET 5/8" X24" REBAR WITH PLASTIC CAP
- FOUND 1" IRON PIPE

SURVEY SIGN POST 1' NORTH & 1' WEST OF MONUMENT

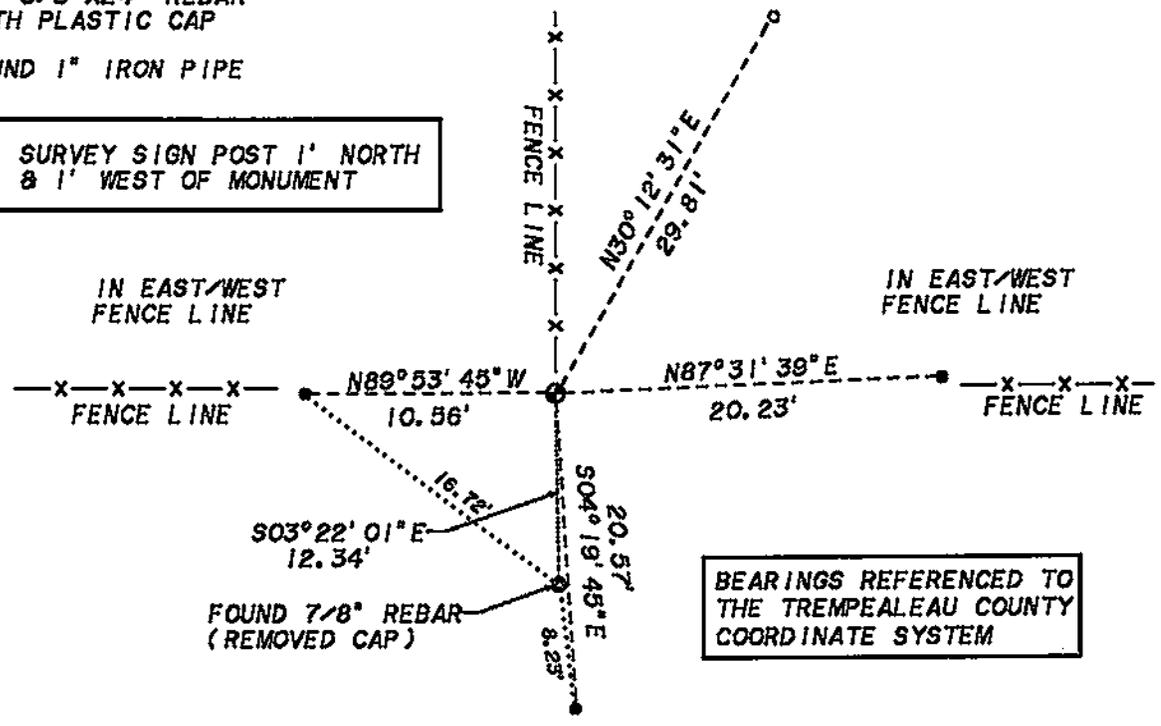

no scale

Corner Identifier number 80-316

Describe any material discrepancy between the location of the corner as restored or reestablished and the location of that corner as previously restored or reestablished by distance and direction. Show the discrepancy on the plan view drawing. Show the distances between the corner as restored or reestablished, and (1) the corner as restored or reestablished, and (2) to at least 2 of the witness monuments shown on the drawing.

**MATERIAL DISCREPANCY AS FOLLOWS:  
RESTORED CORNER TO FOUND 7/8" REBAR = S03°22'01"E, 12.34 FEET  
(BEARING REFERENCED TO THE TREMPLEAU COUNTY COORDINATE SYSTEM)**

Was the corner restored through acceptance of (1) an obliterated evidence location, (2) a found perpetuated location, or (3) an existent corner location?

**AN OBLITERATED EVIDENCE LOCATION.**

Was the corner reestablished through lost corner proportionate methods? If so, show the method including the directions and distances to other public land survey corners used as evidence or used for proportioning in determining the corner location.

**NO.**

Show the corner history of record in chronological order from Original Government Survey to present.

**ORIGINAL GOVERNMENT SURVEY - CYRUS WOODWORTH - SEPTEMBER 1847  
SET QUARTER SECTION POST IN MOUND, PIT 8 LINKS EAST.**

**UNITED STATES ENGINEER OFFICE - WIELDE - JULY 1932  
SURVEYS FOR LOCK AND DAM SYSTEM ALONG THE MISSISSIPPI RIVER. TRAVERSES  
ALONG THE EAST LINE OF SECTION 20-18-8. NOTES INDICATE FINDING A GOOD  
FENCE INTERSECTION OF NORTH, SOUTH, EAST AND WEST FENCES. POSSIBLE  
QUARTER CORNER AT THE EAST QUARTER CORNER OF SECTION 20.**

**PRIVATE LAND SURVEYOR'S RECORDS - S. SOLBERG - OCTOBER 1985  
SURVEYS PARCEL IN SECTION 21-18-8. TIES SURVEY TO THE OCCUPIED WEST  
QUARTER CORNER OF SECTION 21. NO MENTION OF WHAT WAS FOUND OR SET.**

**RECORD OF LAND CORNER PERPETUATION - R. CHALSMAN - AUGUST 1986  
FILES TIE SHEET FOR THE EAST QUARTER CORNER OF SECTION 20-18-8. CALLS FOR  
A SET COUNTY MONUMENT. NO INFORMATION ON SHEET INDICATES SPECIFIC METHOD  
OF REESTABLISHMENT.**

**PRIVATE LAND SURVEYOR'S RECORDS - S. SOLBERG - JANUARY 1992  
SURVEYS PARCEL IN SECTION 21-18-8. TIES SURVEY TO THE WEST QUARTER CORNER  
OF SECTION 21. SHOWS SYMBOL, BUT NO MENTION OF WHAT WAS FOUND OR SET.**

**CERTIFIED SURVEY MAPS - S. SOLBERG - APRIL 1994  
RECORDS TWO MAPS FOR PARCELS IN SECTION 21-18-8. MAPS CALL FOR A COUNTY  
MARKER FOUND AT THE WEST QUARTER CORNER OF SECTION 21.**

**PRIVATE LAND SURVEYOR'S RECORDS - S. SOLBERG - JANUARY 1994  
SURVEYS PARCELS IN SECTION 21-18-8. CALLS FOR A FOUND COUNTY MARKER AT  
THE WEST QUARTER CORNER OF SECTION 21.**

Affix Land Surveyor Seal

I, JOSEPH P. NELSEN  
certify that the corner location shown on this record  
was determined by me or under my direction and control  
and that this U.S. Public Land Survey Monument Record  
is correct to the best of my knowledge and belief.

Joseph P. Nelsen 9-21-99  
Signature Date

