

111
18-8

21808210000

LA CROSSE COUNTY

U.S. PUBLIC LAND SURVEY MONUMENT RECORD

SECTION Corner common to Sections 21, 22, 27 & 28

T. 18 N., R. 8 W.

Type of monument 7/8" X60" REBAR

Location indicated on sketch - ⊙ -

21	22
28	27


Location Sketch

Describe any record evidence, monument evidence, occupational evidence, testimonial evidence or any other material evidence you considered, and whether the monument was found or placed.

ORIGINAL GOVERNMENT ACCESSORIES WERE SEARCHED FOR, BUT NOTHING WAS FOUND. OTHER MONUMENT EVIDENCE WAS SEARCHED FOR, BUT NONE WAS FOUND. IN 1932 THE U.S.E.O. TRAVERSED THE EAST LINE OF SECTION 21-18-8, AS WELL AS OTHER SECTION LINES IN THIS AREA. THE NOTES OF THIS SURVEY INDICATE FINDING A FENCE INTERSECTION OF FENCE LINES NORTH/SOUTH AND EAST NEAR THE EAST QUARTER CORNER OF SECTION 21-18-8, FINDING A FENCE INTERSECTION OF FENCE LINES NORTH/SOUTH AND WEST NEAR THE EAST 1/8TH CORNER OF THE SOUTHEAST QUARTER OF SECTION 21-18-8 AND FINDING AN EAST/WEST FENCE LINE NEAR THE NORTHEAST CORNER OF SECTION 28-18-8. THESE THREE POSITIONS WERE SEARCHED FOR EVIDENCE OF THESE FENCE LINES. IT WAS FOUND THAT FLOODWATERS AND LOGGING OPERATIONS HAVE OBLITERATED THESE FENCE LINES. A POSITION FOR THIS CORNER WAS DETERMINED BASED UPON RETRACING U.S.E.O. POSITIONS OF THESE THREE LOCATIONS. THE NORTH/SOUTH POSITION OF THIS CORNER WAS DETERMINED BY HOLDING THE RETRACED POSITION OF THE EAST/WEST FENCE LINE AT THE NORTHEAST CORNER OF SECTION 28-18-8. THE EAST/WEST POSITION OF THIS CORNER WAS DETERMINED BY HOLDING THE PROJECTION OF LINE FROM THE RETRACED FENCE INTERSECTION AT THE EAST QUARTER CORNER OF SECTION 21-18-8 THROUGH THE RETRACED POSITION OF THE NORTH/SOUTH FENCE LINE AT THE EAST 1/16TH OF THE SOUTHEAST QUARTER OF SECTION 21-18-8. THIS POSITION FALLS ON A VERY REMNANT EAST/WEST FENCE LINE. THIS POSITION MATCHES THE "DOUBLE OVER" OF LINE AND DISTANCE FROM THE NORTHEAST CORNER OF SECTION 21-18-8 AND THE RETRACED POSITION OF OCCUPATION AT THE EAST QUARTER CORNER OF SECTION 21-18-8 BY LESS THAN 1 FOOT NORTH/SOUTH AND BY LESS THAN 8 FEET EAST/WEST. IT ALSO MATCHES ORIGINAL GOVERNMENT DISTANCE TO THE SOUTHEAST CORNER OF SECTION 28-18-8 BY ABOUT 8 FEET. THEREFORE, BELIEVING THIS POSITION, AS DESCRIBED, TO BE THE BEST AVAILABLE EVIDENCE OF THIS CORNER'S ORIGINAL LOCATION, A 7/8" X60" REBAR WAS SET AND REFERENCED AS SHOWN BELOW.

Show a plan view drawing depicting the relevant monuments, providing reference ties to at least 4 witness monuments. Describe witness monuments. Show relationship to occupation.

- o SET 5/8" X24" REBAR WITH PLASTIC CAP

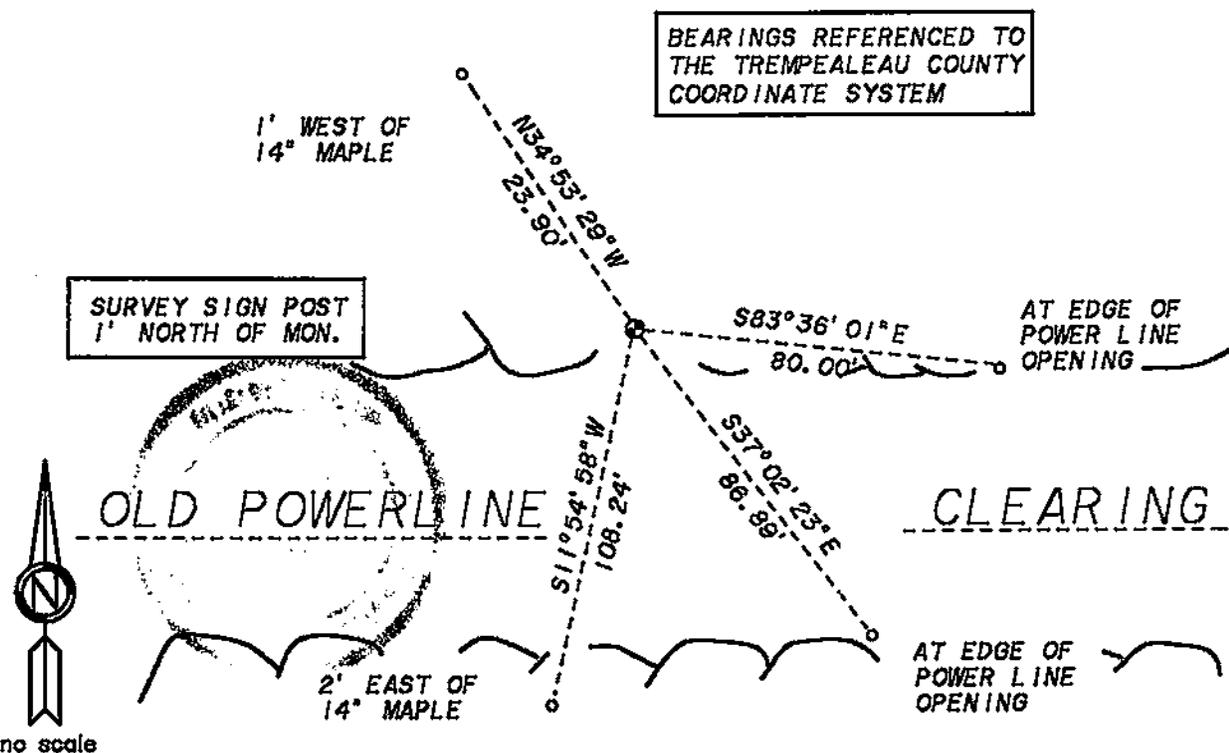

Corner Identifier number

72-320

no scale

Describe any material discrepancy between the location of the corner as restored or reestablished and the location of that corner as previously restored or reestablished by distance and direction. Show the discrepancy on the plan view drawing. Show the distances between the corner as restored or reestablished, and (1) the corner as restored or reestablished, and (2) to at least 2 of the witness monuments shown on the drawing.

NO MATERIAL DISCREPANCY WAS FOUND.

Was the corner restored through acceptance of (1) an obliterated evidence location, (2) a found perpetuated location, or (3) an existent corner location?

AN OBLITERATED EVIDENCE LOCATION.

Was the corner reestablished through lost corner proportionate methods? If so, show the method including the directions and distances to other public land survey corners used as evidence or used for proportioning in determining the corner location.

NO.

Show the corner history of record in chronological order from Original Government Survey to present.

**ORIGINAL GOVERNMENT SURVEY - CYRUS WOODWORTH - SEPTEMBER 1847
SET POST FOR SECTION CORNER. MARKED TWO BEARING TREES.**

**UNITED STATES ENGINEER OFFICE - WIELDE - JULY 1932
SURVEYS FOR THE LOCK AND DAM SYSTEM ALONG THE MISSISSIPPI RIVER. TRAVERSES
IN ALL FOUR CARDINAL DIRECTIONS FROM THE NORTHEAST CORNER OF SECTION
28-18-8. NOTES INDICATE FINDING AN EAST/WEST FENCE LINE NEAR THE
NORTHEAST CORNER OF SECTION 28-18-8.**

Affix Land Surveyor Seal

I, JOSEPH P. NELSEN

certify that the corner location shown on this record was determined by me or under my direction and control and that this U.S. Public Land Survey Monument Record is correct to the best of my knowledge and belief.

Joseph P. Nelsen
Signature

9-20-99
Date

