

LA CROSSE COUNTY

U.S. PUBLIC LAND SURVEY MONUMENT RECORD

QUARTER Corner common to Sections 21 & 22

T. 18 N., R. 8 W.

Type of monument 7/8" X 60" REBAR

Location indicated on sketch -  -


21	22
21	22

Location Sketch

Describe any record evidence, monument evidence, occupational evidence, testimonial evidence or any other material evidence you considered, and whether the monument was found or placed.

ORIGINAL GOVERNMENT ACCESSORIES WERE SEARCHED FOR, BUT NOTHING WAS FOUND. OTHER MONUMENT EVIDENCE WAS SEARCHED FOR, BUT NONE WAS FOUND. THE U.S.E.O., IN THEIR 1932 SURVEY, FOUND A FENCE INTERSECTION OF FENCE LINES NORTH/SOUTH AND EAST. THIS FENCE INTERSECTION WAS SEARCHED FOR. A VERY REMNANT, TREE TO TREE FENCE LINE WAS FOUND NORTH/SOUTH. VERY IRREGULAR BITS AND PIECES OF A FENCE LINE TO THE EAST WERE FOUND, OBVIOUS OBLITERATED BY FLOOD WATERS. RETRACING U.S.E.O. SURVEY OF 1932 DETERMINED THE POSITION OF THE FENCE INTERSECTION. HOLDING THIS RETRACED FENCE INTERSECTION RESTORED THE EAST/WEST POSITION OF THIS CORNER. THE NORTH/SOUTH POSITION OF THIS CORNER WAS REESTABLISHED BY HOLDING THE SPLIT OF DISTANCE BETWEEN THE NORTHEAST AND SOUTHEAST CORNERS OF SECTION 21-18-8. THIS POSITION MATCHES THE RETRACED FENCE INTERSECTION BY LESS THAN 0.1 FEET. THIS POSITION FALLS ON THE FOUND, REMNANT, NORTH/SOUTH FENCE LINE. THIS POSITION MATCHES LINE BETWEEN THE NORTHEAST AND SOUTHEAST CORNERS OF SECTION 21-18-8 BY LESS THAN 3 FEET. THEREFORE, BELIEVING THIS POSITION, AS DESCRIBED, TO BE THE BEST AVAILABLE EVIDENCE OF THIS CORNER'S ORIGINAL LOCATION, A 7/8" X 60" REBAR WAS SET AND REFERENCED AS SHOWN BELOW.

Show a plan view drawing depicting the relevant monuments, providing reference ties to at least 4 witness monuments. Describe witness monuments. Show relationship to occupation.

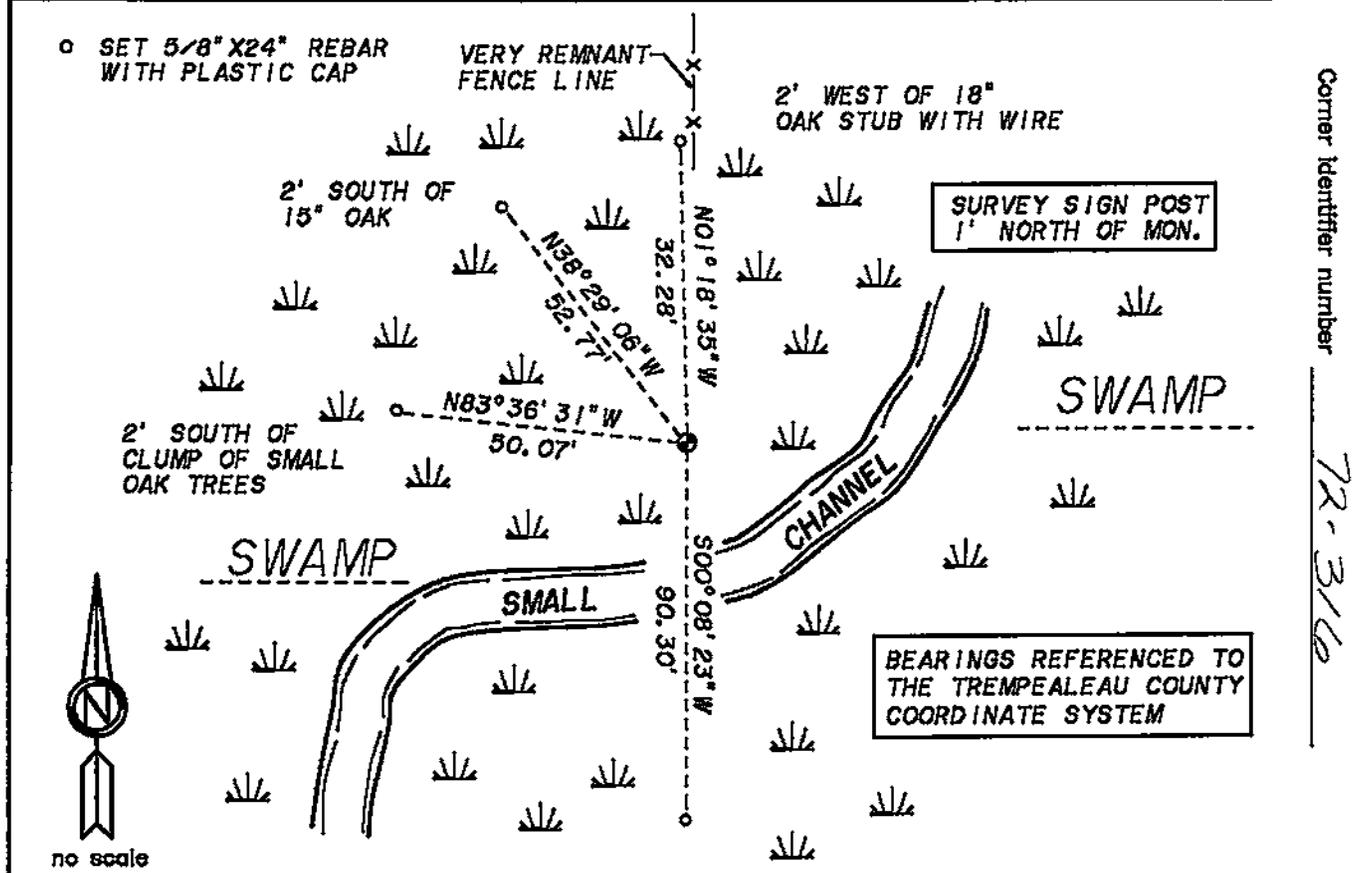

Describe any material discrepancy between the location of the corner as restored or reestablished and the location of that corner as previously restored or reestablished by distance and direction. Show the discrepancy on the plan view drawing. Show the distances between the corner as restored or reestablished, and (1) the corner as restored or reestablished, and (2) to at least 2 of the witness monuments shown on the drawing.

NO MATERIAL DISCREPANCY WAS FOUND.

Was the corner restored through acceptance of (1) an obliterated evidence location, (2) a found perpetuated location, or (3) an existent corner location?

THE EAST/WEST POSITION OF THIS CORNER WAS RESTORED THROUGH AN OBLITERATED EVIDENCE LOCATION.

Was the corner reestablished through lost corner proportionate methods? If so, show the method including the directions and distances to other public land survey corners used as evidence or used for proportioning in determining the corner location.

**THE NORTH/SOUTH POSITION OF THIS CORNER WAS REESTABLISHED THROUGH LOST CORNER METHODS. THE SPLIT OF DISTANCE WAS USED BETWEEN THE NORTHEAST AND SOUTHEAST CORNERS OF SECTION 21-18-8.
NORTHEAST CORNER TO EAST QUARTER CORNER = $300^{\circ}00'12''$ E, 2622.77 FEET.
EAST QUARTER CORNER TO SOUTHEAST CORNER = $300^{\circ}07'28''$ E, 2622.76 FEET.
(BEARINGS REFERENCED TO THE TREMPLEAU COUNTY COORDINATE SYSTEM)**

Show the corner history of record in chronological order from Original Government Survey to present.

**ORIGINAL GOVERNMENT SURVEY - CYRUS WOODWORTH - SEPTEMBER 1847
SET QUARTER SECTION POST. MARKED TWO BEARING TREES.**

**UNITED STATES ENGINEER OFFICE - WIELDE - JULY 1932
SURVEYS FOR THE LOCK AND DAM SYSTEM ALONG THE MISSISSIPPI RIVER.
TRAVERSES THE EAST LINE OF SECTION 21-18-8. NOTES INDICATE FINDING A
FENCE INTERSECTION OF FENCE LINES NORTH/SOUTH AND EAST NEAR THE EAST
QUARTER CORNER OF SECTION 21.**

I, JOSEPH P. NELSEN
certify that the corner location shown on this record
was determined by me or under my direction and control
and that this U.S. Public Land Survey Monument Record
is correct to the best of my knowledge and belief.

Joseph P. Nelsen 9-21-99
Signature Date

Affix Land Surveyor Seal

