


U. S. PUBLIC LAND SURVEY MONUMENT RECORD

SECTION 25 T 18 N, R 8 W, TOWN OF HOLLAND
 LA CROSSE COUNTY

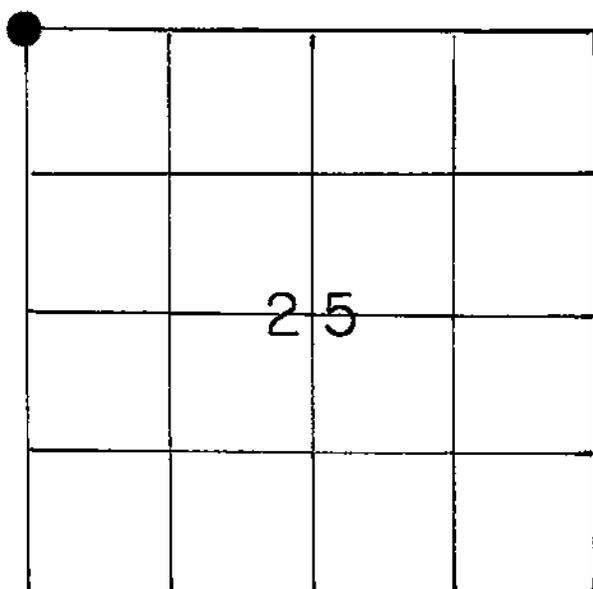

LOCATION OF LANDMARK

South Zone	
WISCONSIN COORDINATE SYSTEM	
North	736,478.878
East	1,660,460.871
Theta Angle	
Horiz. Order	
Vert. Order	
TYPE OF LANDMARK	
Brass Capped Lunde Marker	
BEARINGS ARE REFERENCED TO	
Grid	

Crew: William Jung
 Perry Dahl
 5/29/86

Describe any record evidence, monument evidence, testimonial evidence or any other material evidence you considered and whether the monument was found or restored through acceptance of an obliterated evidence location.

I found a railroad spike and nail at the corner. This point has been used as the corner in previous surveys. I accepted this point as the best available evidence of the original government corner position, removed it, and set a Brass Capped Lunde Marker. The marker is down 1" with P.K. nails 1' South and 1' West.

Describe or show any material discrepancy between the location of the restored corner and that of the corner previously restored or reestablished.

None known.

