


21808232020

## U. S. PUBLIC LAND SURVEY MONUMENT RECORD

SECTION 23 T 18 N, R 8 W, TOWN OF HOLLAND

LA CROSSE COUNTY

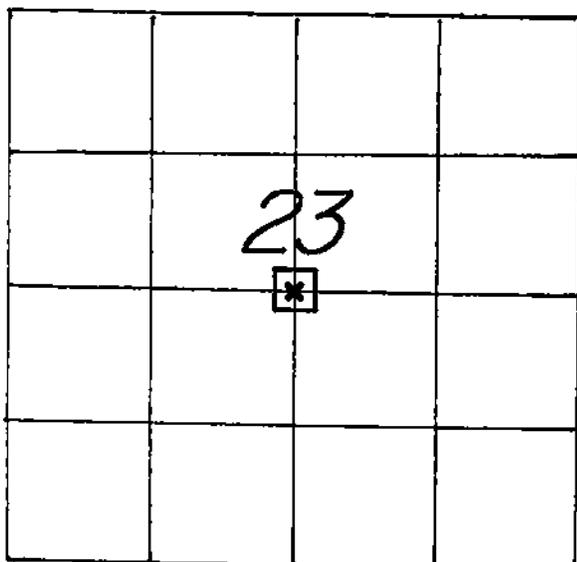

WISCONSIN COORDINATE SYSTEM

North

East

Theta Angle

Horiz. Order

Vert. Order

TYPE OF LANDMARK

FIELDSTONE WITH A HOLE IN THE TOP.

BEARINGS ARE REFERENCED TO

## LOCATION OF LANDMARK

CREW: WILLIAM C. JUNG  
 PETER F. FOLLANSBEE  
 DATE: 9/30/2004

Describe any record evidence, monument evidence, testimonial evidence or any other material evidence you considered and whether the monument was found or restored through acceptance of an obliterated evidence location.


We found a fieldstone at the old occupied corner. This stone had been used as the center of section in a number of previous surveys. As the old county surveyor records are lost, we do not know who set the stone. I would suspect that it might have been Mr. Van Loon. After analyzing the records and section data, it is my opinion that this old stone should be accepted and used as the center of section monument.

Describe or show any material discrepancy between the location of the restored corner and that of the corner previously restored or reestablished.

**NONE KNOWN.**


RECORD OF DURABLE WITNESS MONUMENTS

NO	DESCRIPTION	MAGNETIC	
		BEARING	DISTANCE
1	SET A NAIL IN N.W.-SIDE OF A 10" OAK	N 36° E	25.55 FT.
2	SET A NAIL IN N.W.-SIDE OF A 23" WHITE PINE	N 65° E	53.00 FT.
3	SET A NAIL IN N.W.-SIDE OF A 16" WHITE PINE	S 12° W	25.00 FT.
4	SET A NAIL IN N.W.-SIDE OF AN 18" WHITE PINE	S 31° W	24.90 FT.

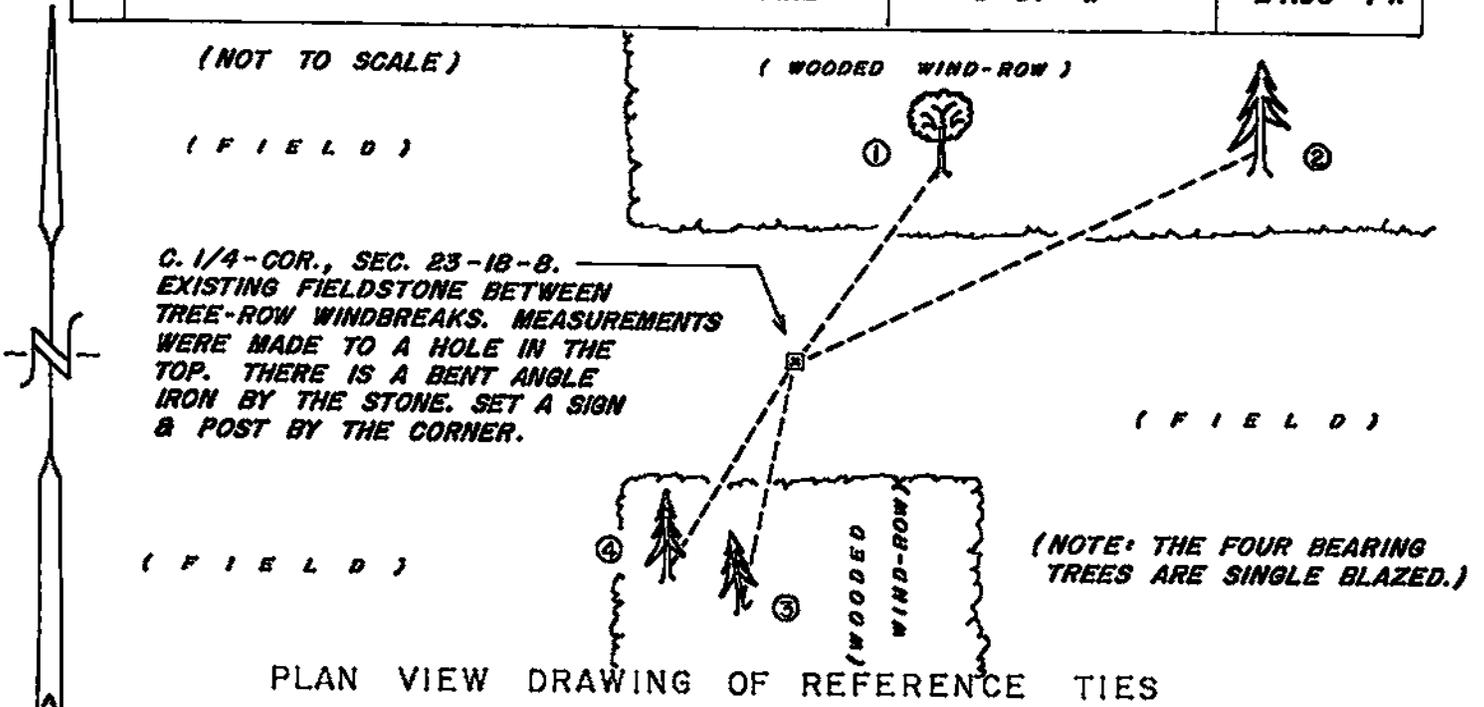

MAP SHOWING DISTANCE AND DIRECTION TO OTHER PUBLIC LAND SURVEY CORNERS USED FOR REESTABLISHING THE CORNER


(NOT TO SCALE)

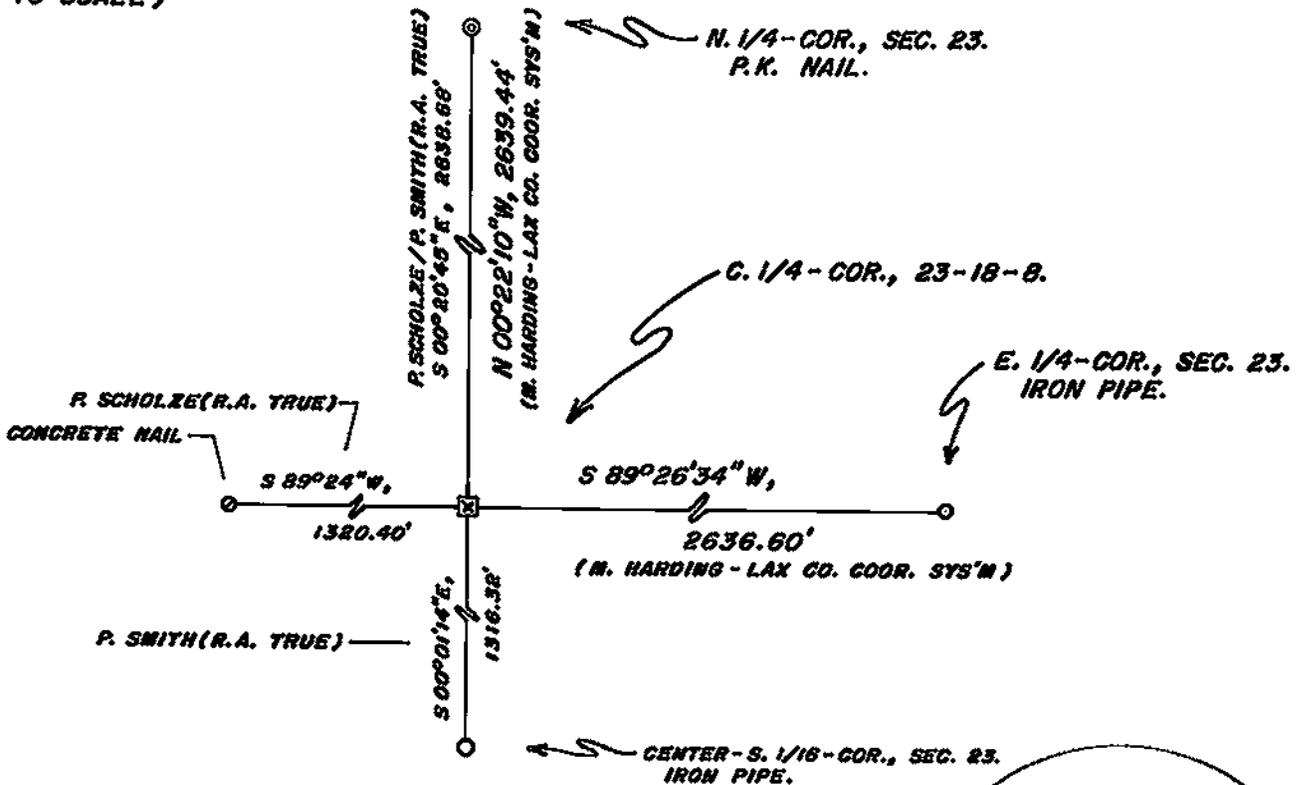

I, WILLIAM C. JUNG, COUNTY SURVEYOR  
HEREBY CERTIFY THAT THE CORNER LOCATION SHOWN ON THIS RECORD WAS DETERMINED BY ME OR UNDER MY DIRECTION AND CONTROL AND THAT THIS U. S. PUBLIC LAND SURVEY MONUMENT RECORD IS CORRECT AND COMPLETE TO THE BEST OF MY KNOWLEDGE AND BELIEF.

William C. Jung  
Signature

12/23/04  
Date

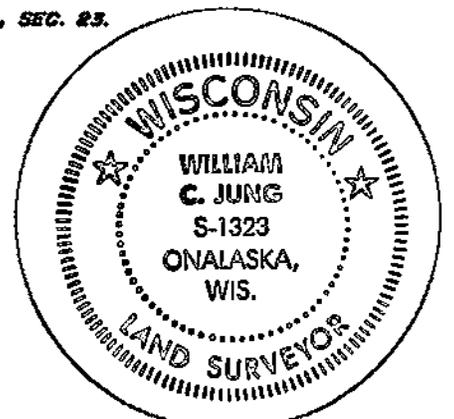

Seal