


21808240020

U. S. PUBLIC LAND SURVEY MONUMENT RECORD

SECTION 25 T 18 N, R 8 W, TOWN OF HOLLAND

LA CROSSE COUNTY

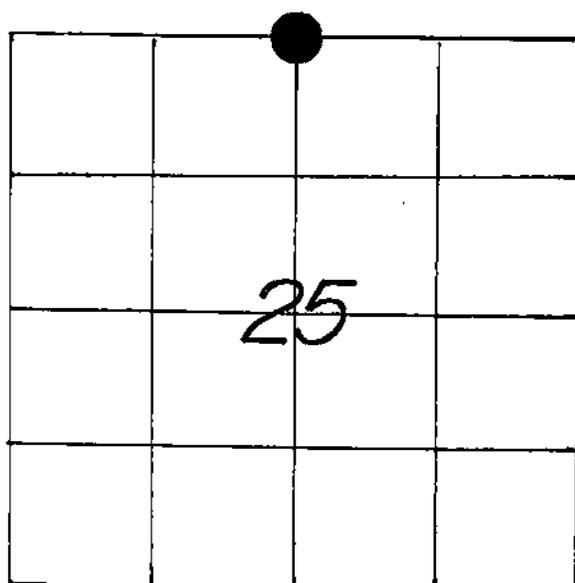

WISCONSIN COORDINATE SYSTEM

North 736,407.294

East 1,631,549.953

Theta Angle

Horiz. Order

Vert. Order

83(91) datum

TYPE OF LANDMARK

1-1/4" IRON BAR.

BEARINGS ARE REFERENCED TO

LOCATION OF LANDMARK

CREW: WILLIAM C. JUNG
 PETER F. FOLLANSBEE
 DATE: 6/26/2008

Describe any record evidence, monument evidence, testimonial evidence or any other material evidence you considered and whether the monument was found or restored through acceptance of an obliterated evidence location.


In 1990 Bob Chalsma computed out the location of this corner as at the single proportionate position while surveying out Section 24. In 2001 K.Den Pederson remeasured the full mile. Dick Berg measured the mile again and agreed with Chalsma's location and monumented it with a 1 1/4" iron bar. Dick and I discussed this corner at length. I agree with the single proportionate position and tied off Berg's iron bar.

Describe or show any material discrepancy between the location of the restored corner and that of the corner previously restored or reestablished.


NONE KNOWN.

RECORD OF DURABLE WITNESS MONUMENTS

NO	DESCRIPTION	MAGNETIC	
		BEARING	DISTANCE
1	EXIST. MAG NAIL IN S.W.-SIDE OF 32" WHITE OAK	N 29° W	16.52 FT.
2	EXIST. MAG NAIL IN N.W.-SIDE OF A 6" ELM	N 72° E	11.45 FT.
3	SET A P.K. NAIL IN S.W.-SIDE OF A 6" ELM	S 45° E	28.91 FT.
4	EXIST. MAG NAIL IN N.-SIDE OF AN 8" ELM	S 20° E	34.71 FT.

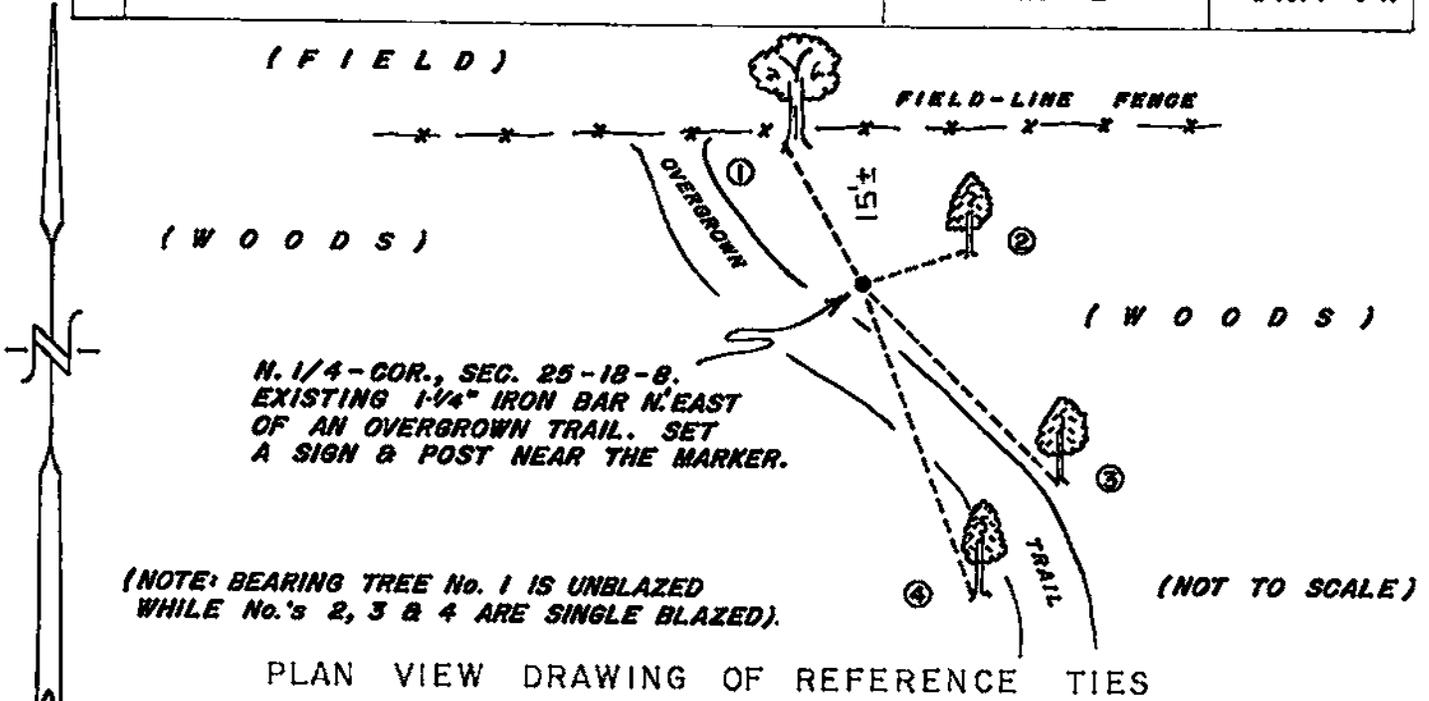

MAP SHOWING DISTANCE AND DIRECTION TO OTHER PUBLIC LAND SURVEY CORNERS USED FOR REESTABLISHING THE CORNER

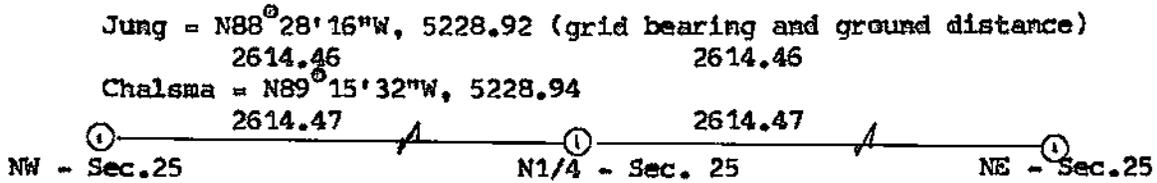

I, WILLIAM C. JUNG, COUNTY SURVEYOR
HEREBY CERTIFY THAT THE CORNER LOCATION SHOWN ON THIS RECORD
WAS DETERMINED BY ME OR UNDER MY DIRECTION AND CONTROL AND
THAT THIS U. S. PUBLIC LAND SURVEY MONUMENT RECORD IS CORRECT
AND COMPLETE TO THE BEST OF MY KNOWLEDGE AND BELIEF.

William C. Jung 9/10/08
Signature Date



Seal