


## U. S. PUBLIC LAND SURVEY MONUMENT RECORD

SECTION 36 T 18 N, R 8 W, TOWN OF HOLLAND

LA CROSSE COUNTY

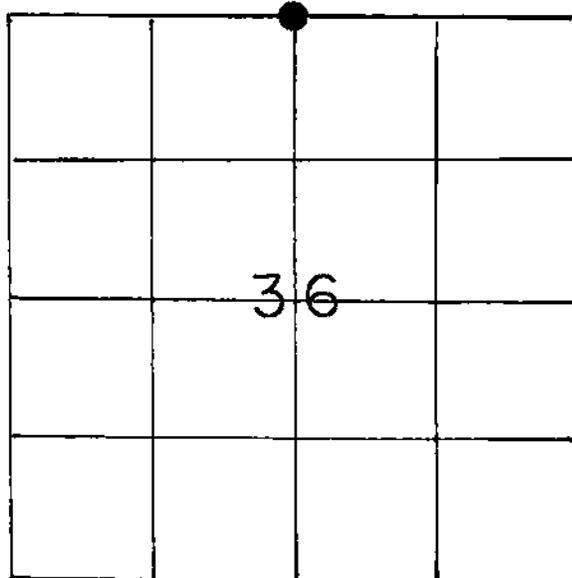

LOCATION OF LANDMARK

Crew: William Jung  
Perry Dahl  
4/11/86

Crew: William C. Jung  
Peter F. Follansbee  
5/28/92

South Zone	
WISCONSIN COORDINATE SYSTEM	
North	731,160.233
East	1,663,049.682
Theta Angle	
Horiz. Order	
Vert. Order	
TYPE OF LANDMARK	
1 3/4" x 3' Axle	
BEARINGS ARE REFERENCED TO	
Grid	

Describe any record evidence, monument evidence, testimonial evidence or any other material evidence you considered and whether the monument was found or restored through acceptance of an obliterated evidence location.

Otho Bergman found a pile of stones at the corner in August of 1975 and set a 1/2" rod in the stone pile. I found the rod in the stone pile in the old downed fence row. I removed the rod and set an old 1 3/4" x 3' axle with a round 6" base in a pile of rocks. I also set a steel fence post North of the axle. In my opinion, Bergman found a rock pile that marked the old corner location. I accepted this location. (It also appears that local land owners have also accepted this location as the corner.) \*\*\*\*\*

Describe or show any material discrepancy between the location of the restored corner and that of the corner previously restored or reestablished.

None known.


\*\*\*\*\* The axle was found knocked off plumb, the stone pile strewn about, and the fence post gone. The axle was plumbed up and mounded again with rocks, bricks, etc. Set a sign post 4" to the NE with our sign and a D.O.T. sign on it. Pete found wire while digging.

RECORD OF DURABLE WITNESS MONUMENTS

NO	DESCRIPTION	BEARING	DISTANCE
1	Set 1½" iron pipe	West ±	33.05
2	Set 1½" iron pipe	East ±	33.05
3	Set 1½" iron pipe, about 2' South of the Fence	Grid=S0-27-45W	GRID= 1317.24'
4			




O P E N F I E L D

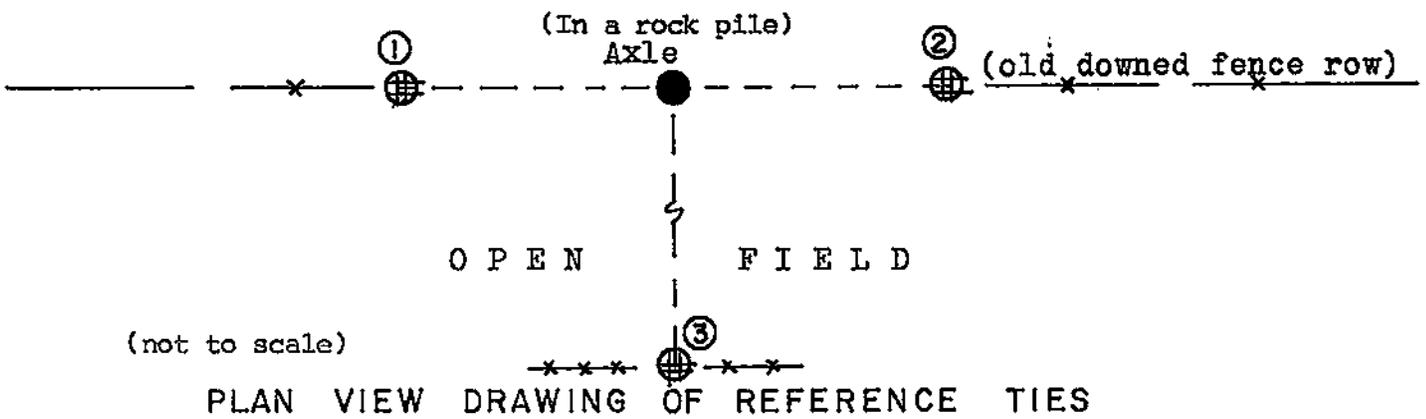

MAP SHOWING DISTANCE AND DIRECTION TO OTHER PUBLIC LAND SURVEY CORNERS USED FOR REESTABLISHING THE CORNER

(not to scale)  
Grid bearings and distances)

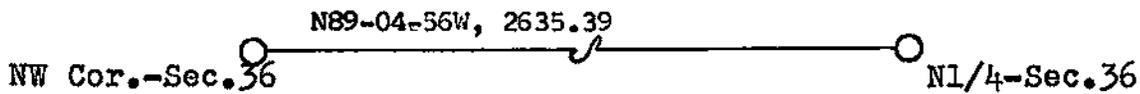


I, William C. Jung, Deputy County Surveyor,  
HEREBY CERTIFY THAT THE CORNER LOCATION SHOWN ON THIS RECORD  
WAS DETERMINED BY ME OR UNDER MY DIRECTION AND CONTROL AND  
THAT THIS U. S. PUBLIC LAND SURVEY MONUMENT RECORD IS CORRECT  
AND COMPLETE TO THE BEST OF MY KNOWLEDGE AND BELIEF.

William C. Jung  
Signature

6/11/86  
Date

Revised: 6/12/92 *W.C.J.*

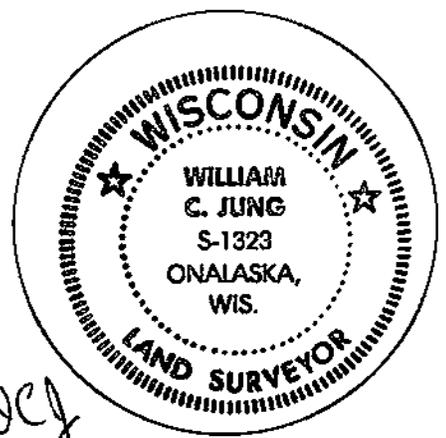

Seal