


U. S. PUBLIC LAND SURVEY MONUMENT RECORD

SECTION 25 T 18 N, R 8 W, TOWN OF HOLLAND

LA CROSSE COUNTY

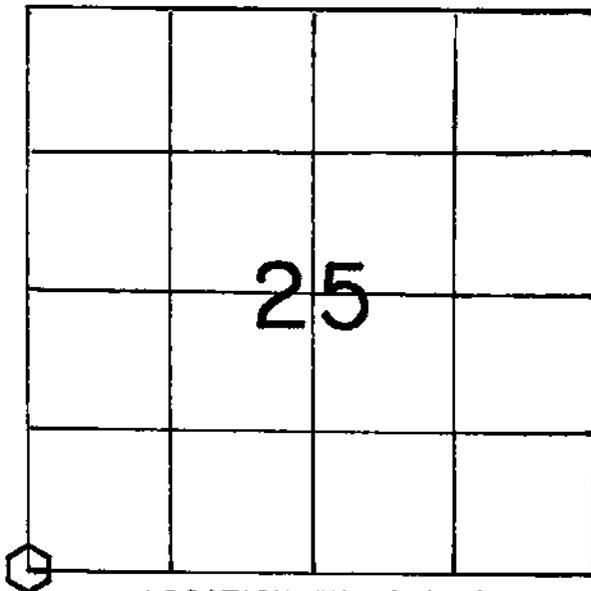

LOCATION OF LANDMARK

Crew: WILLIAM C. JUNG
Peter F. FOLLANSBEE

Date: 7/21/1993

Describe any record evidence, monument evidence, testimonial evidence or any other material evidence you considered and whether the monument was found or restored through acceptance of an obliterated evidence location.

The corner that I set in June of 1986 was destroyed during road construction.
I set a brass capped Lunde marker at the corner location.

Describe or show any material discrepancy between the location of the restored corner and that of the corner previously restored or reestablished.

(Refer to my old voided tie sheet, dated June 11, 1986, and attached to this document.)

South Zone, 1927 Datum

WISCONSIN COORDINATE SYSTEM

North 731,202.441

East 1,660,414.626

Theta Angle

Horiz. Order

Vert. Order

TYPE OF LANDMARK


Set brass cap Lunde marker.

BEARINGS ARE REFERENCED TO

Grid

RECORD OF DURABLE WITNESS MONUMENTS

NO	DESCRIPTION	BEARING	DISTANCE
1	Northwest corner of concrete walk	Southwesterly \pm	105.90 Ft.
2	Set P.K. Nail in building baseboard facing S.E.	Southwesterly \pm	112.03 Ft.
3	Set 1" Iron Pipe	S 05° E (Mag.)	78.48 Ft.
4	Exist. 1" Iron Pipe 3.3' from center of F.-post	Southeasterly \pm	297.94 Ft.

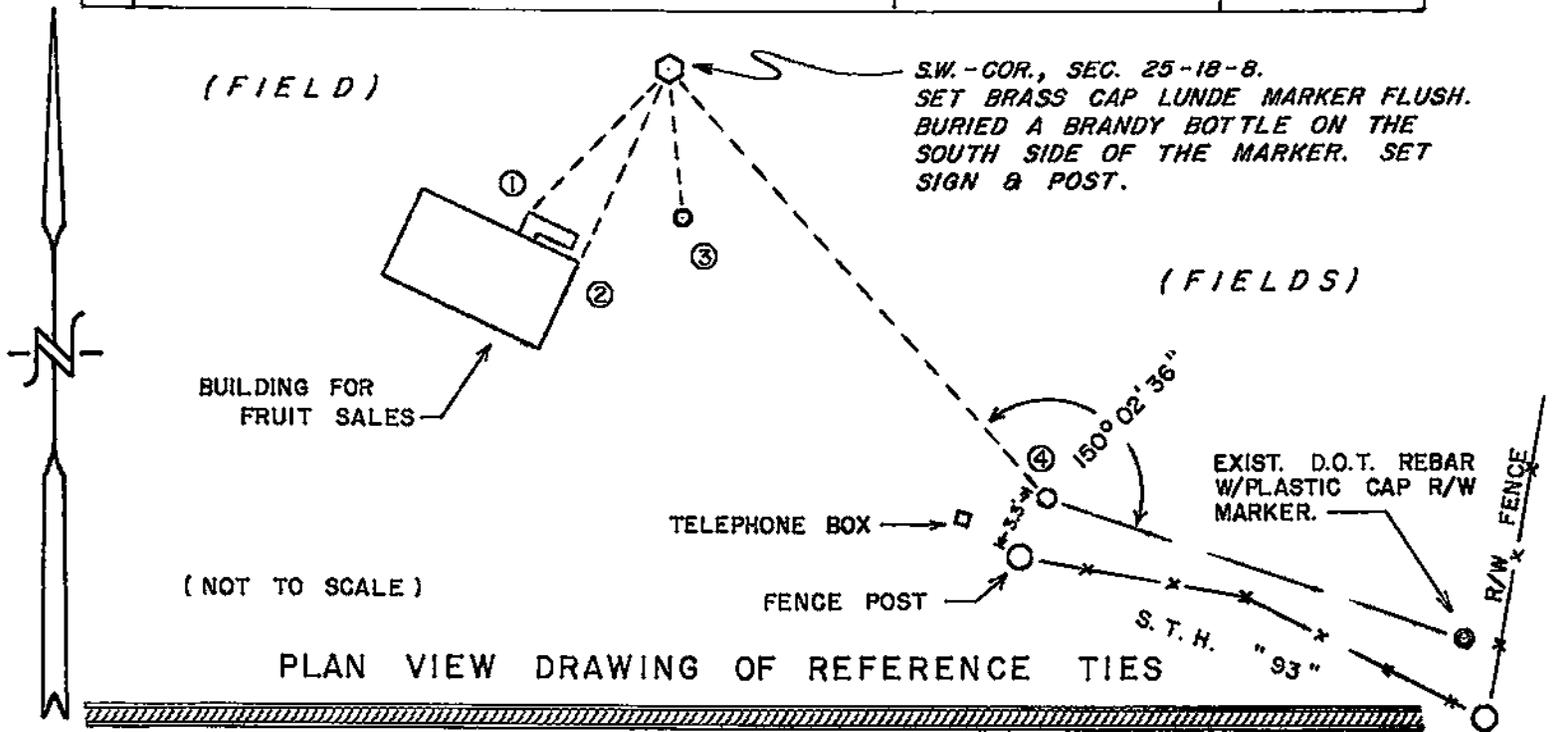

MAP SHOWING DISTANCE AND DIRECTION TO OTHER PUBLIC LAND SURVEY CORNERS USED FOR REESTABLISHING THE CORNER

(Refer to my old voided tie sheet, dated June 11, 1986, and attached to this document.)

I, William C. Jung, County Surveyor
 HEREBY CERTIFY THAT THE CORNER LOCATION SHOWN ON THIS RECORD
 WAS DETERMINED BY ME OR UNDER MY DIRECTION AND CONTROL AND
 THAT THIS U. S. PUBLIC LAND SURVEY MONUMENT RECORD IS CORRECT
 AND COMPLETE TO THE BEST OF MY KNOWLEDGE AND BELIEF.


William C. Jung 1/24/94
 Signature Date



Seal

U. S. PUBLIC LAND SURVEY MONUMENT RECORD

SECTION 36 T 18 N, R 8 W, TOWN OF HOLLAND
LA CROSSE COUNTY

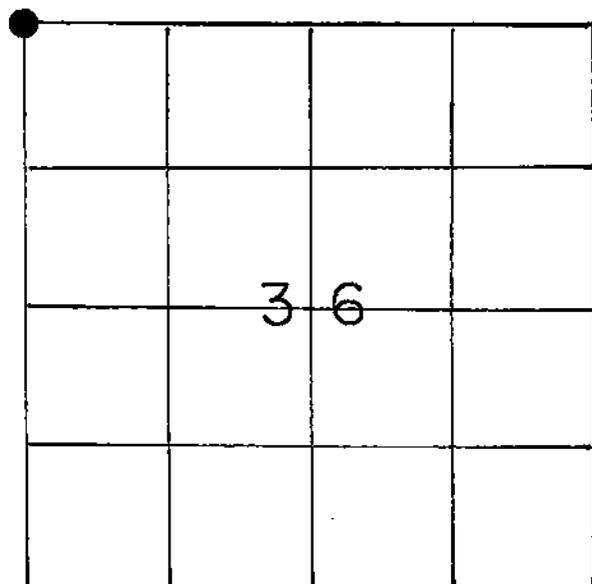

LOCATION OF LANDMARK

Crew: William Jung
 Perry Dahl
 6/2/86

South Zone

WISCONSIN COORDINATE SYSTEM	
North	731,202.441
East	1,660,414.626
Theta Angle	
Horiz. Order	
Vert. Order	
TYPE OF LANDMARK	
Railroad Spike	
BEARINGS ARE REFERENCED TO	
Grid	

Describe any record evidence, monument evidence, testimonial evidence or any other material evidence you considered and whether the monument was found or restored through acceptance of an obliterated evidence location.

In 1980 Rob Lampman surveyed out Section 26 and computed a location for this corner. I agreed with his location and set a railroad spike at that point. My computations would indicate that this location best fits the overall field conditions.



Describe or show any material discrepancy between the location of the restored corner and that of the corner previously restored or reestablished.

The 1952 highway map of S.T.H. "93" shows the corner to be 12.7 feet South of the centerline. Clark's 1982 map in Section 35 shows the corner to be 12.7 feet South of a P.K. nail. Murphy's 1982 computations also show the corner to be 12.7 feet South of the centerline, only 12.7 feet South of a 60d spike. This 60d spike was probably Lampman's survey point. Steve Solberg did a survey in Section 26 but he did not go to this corner. The new R/W map for the proposed Hwy. "53" appears to show the corner in the centerline of "93". Derald Kading from the D.O.T. said that the 1952 notes were lost. He also said not to put too much faith in the 1952 map as it shows the corner as being approximate. Clark's P.K. nail and Lampman's 60d spike (temporary survey point) show on the sketch on the back page of this tie sheet.

(VOID)
wef

RECORD OF DURABLE WITNESS MONUMENTS

NO	DESCRIPTION	BEARING	DISTANCE
1	P.K. in hack in double blazed 10" Norway	-----	56.87
2	Set 1 1/2" iron pipe	-----	39.88
3	P.K. nail and cap set by me	-----	18.11
4	To the center of a utility box	-----	60.1

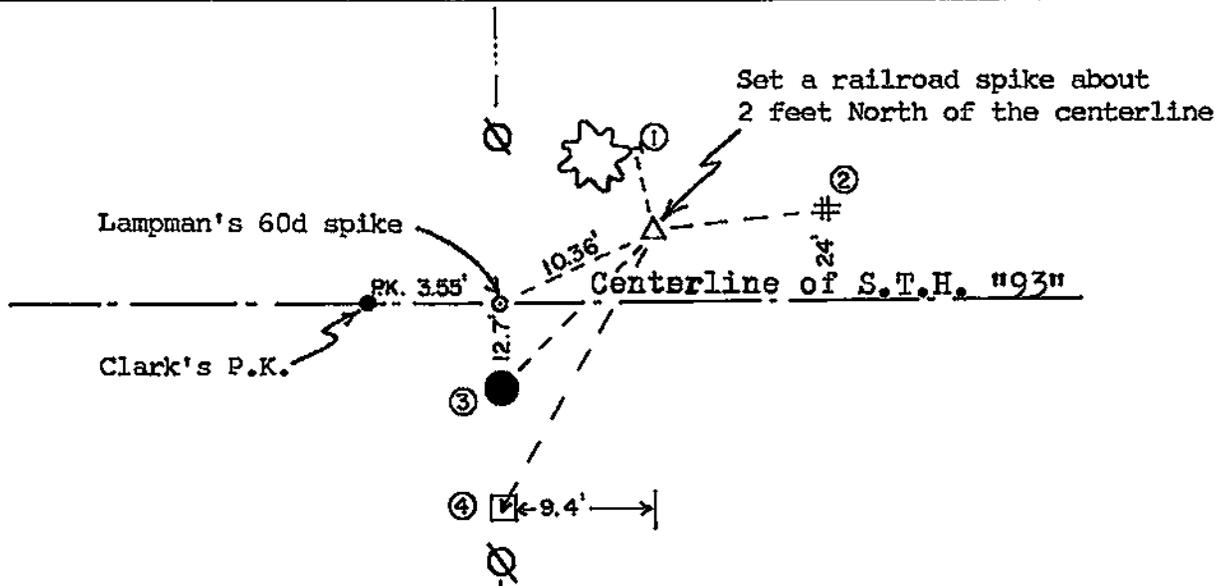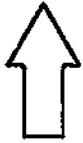


PLAN VIEW DRAWING OF REFERENCE TIES



MAP SHOWING DISTANCE AND DIRECTION TO OTHER PUBLIC LAND SURVEY CORNERS USED FOR REESTABLISHING THE CORNER
(not to scale)

Grid bearings and distances

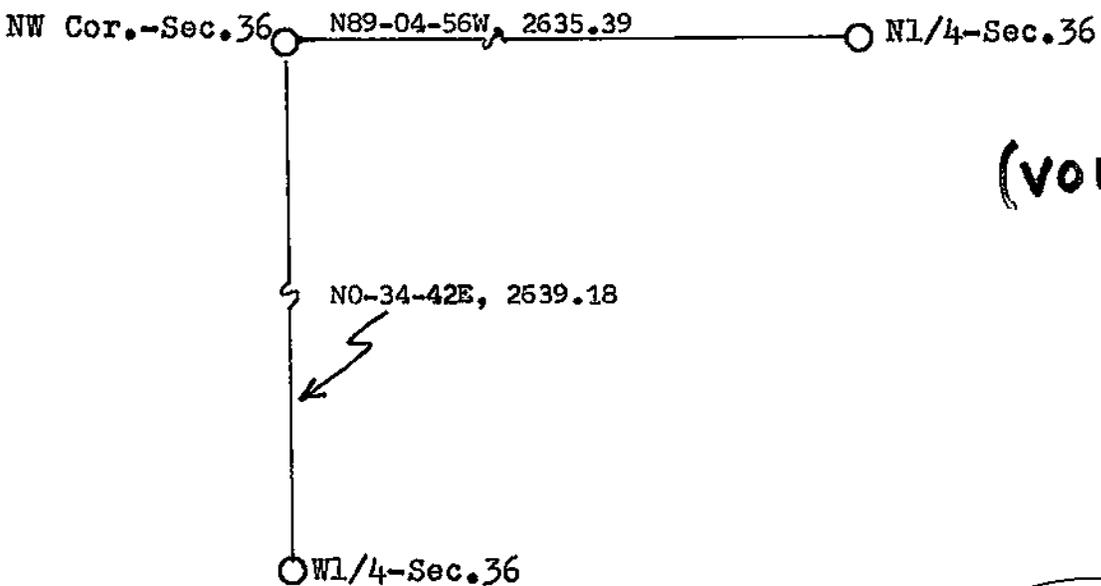

(VOID) *awef*

I, William C. Jung, Deputy County Surveyor,
HEREBY CERTIFY THAT THE CORNER LOCATION SHOWN ON THIS RECORD
WAS DETERMINED BY ME OR UNDER MY DIRECTION AND CONTROL AND
THAT THIS U. S. PUBLIC LAND SURVEY MONUMENT RECORD IS CORRECT
AND COMPLETE TO THE BEST OF MY KNOWLEDGE AND BELIEF.

William C. Jung
Signature

6/11/86
Date



Seal