


21808260020

U. S. PUBLIC LAND SURVEY MONUMENT RECORD

SECTION 35 T 18 N, R 8 W, TOWN OF HOLLAND

LA CROSSE COUNTY

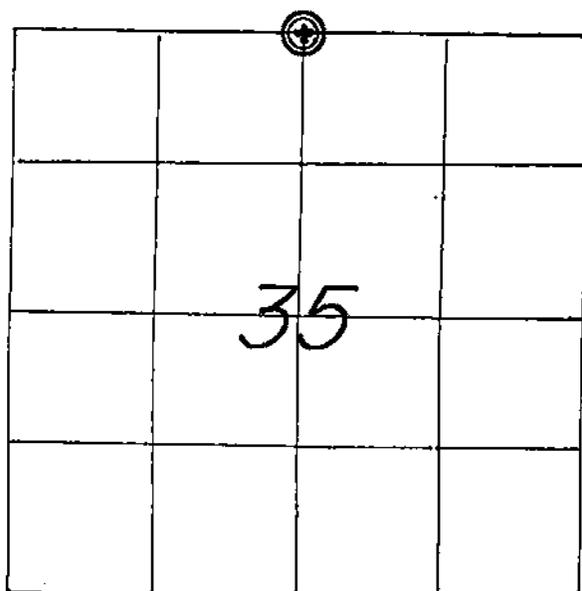

WISCONSIN COORDINATE SYSTEM

North

East

Theta Angle

Horiz. Order

Vert. Order

TYPE OF LANDMARK

3/4" x 30" IRON BAR WITH ALUMINUM CAP.

BEARINGS ARE REFERENCED TO

GRID NORTH.

LOCATION OF LANDMARK

CREW: *WILLIAM C. JUNG*
*PETER F. FOLLANSBEE*DATE: *8/03/1999*

Describe any record evidence, monument evidence, testimonial evidence or any other material evidence you considered and whether the monument was found or restored through acceptance of an obliterated evidence location.


This corner was set by single proportionate measurement.

Describe or show any material discrepancy between the location of the restored corner and that of the corner previously restored or reestablished.


NONE KNOWN.

RECORD OF DURABLE WITNESS MONUMENTS

NO	DESCRIPTION	BEARING	DISTANCE
1	EX. 3/4" x 30" IRON BAR SURVEY POINT	S 56°09'58"W (GRID)	66.09' (GRID)
2	SET A NAIL IN W-SIDE 9-1/2" NORWAY (double blazed)	S 02° W (MAG.)	81.92' (GR'ND)
3	SET A NAIL IN N.E.-SIDE 9" NORWAY "	S 22° E (")	67.51' (")
4	SET A NAIL IN S.W.-SIDE 7" NORWAY "	S 51° E (")	96.20' (")

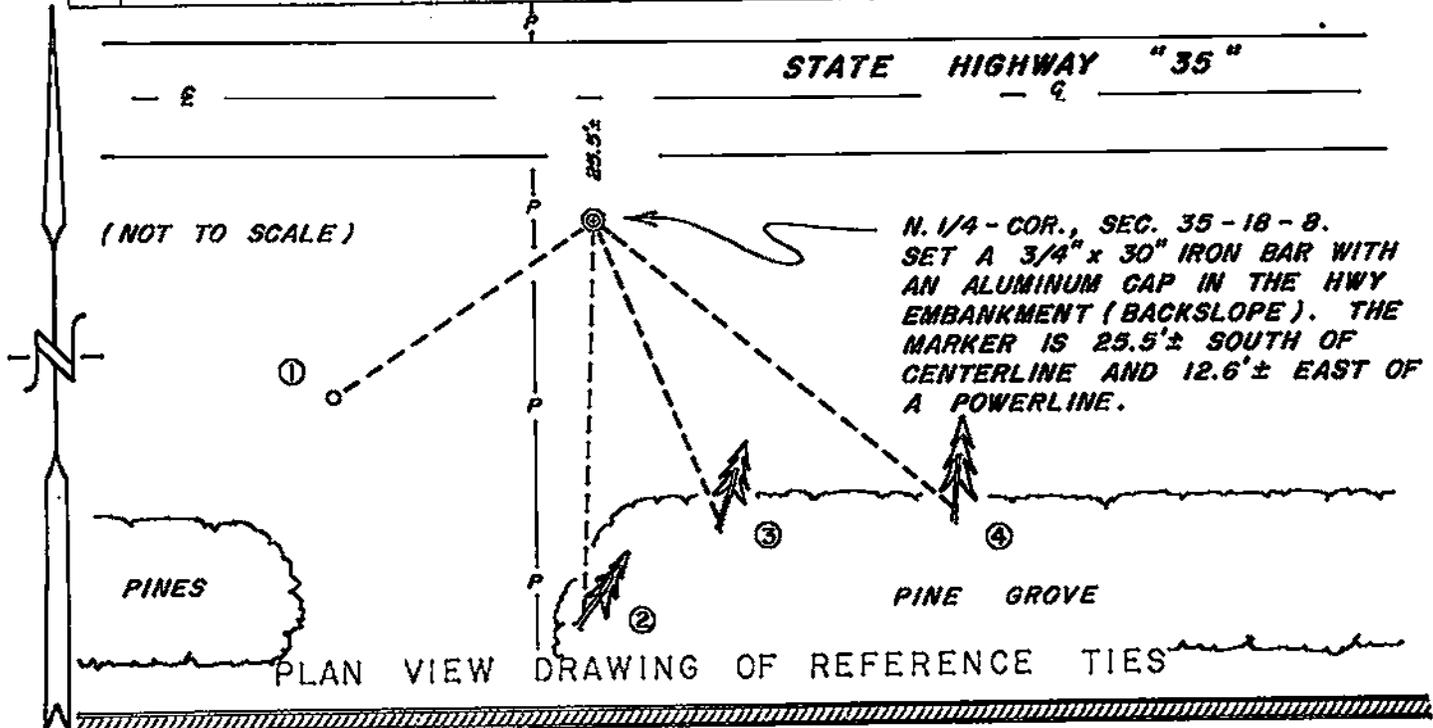

MAP SHOWING DISTANCE AND DIRECTION TO OTHER PUBLIC LAND SURVEY CORNERS USED FOR REESTABLISHING THE CORNER

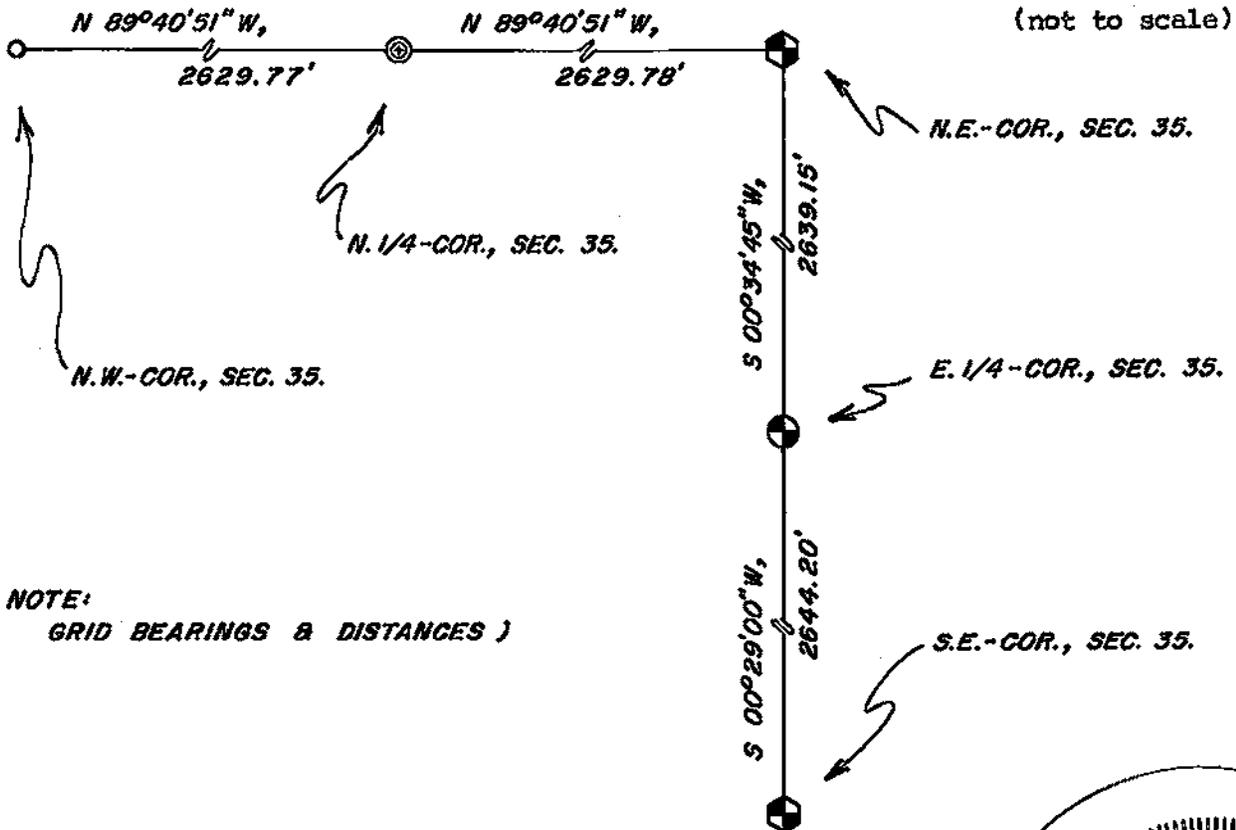

(NOTE: GRID BEARINGS & DISTANCES)

I, WILLIAM C. JUNG, COUNTY SURVEYOR
 HEREBY CERTIFY THAT THE CORNER LOCATION SHOWN ON THIS RECORD
 WAS DETERMINED BY ME OR UNDER MY DIRECTION AND CONTROL AND
 THAT THIS U. S. PUBLIC LAND SURVEY MONUMENT RECORD IS CORRECT
 AND COMPLETE TO THE BEST OF MY KNOWLEDGE AND BELIEF.

William C. Jung
 Signature

9/15/99
 Date



Seal