


U. S. PUBLIC LAND SURVEY MONUMENT RECORD

SECTION 35 T 18 N, R 8 W, TOWN OF HOLLAND

LA CROSSE COUNTY

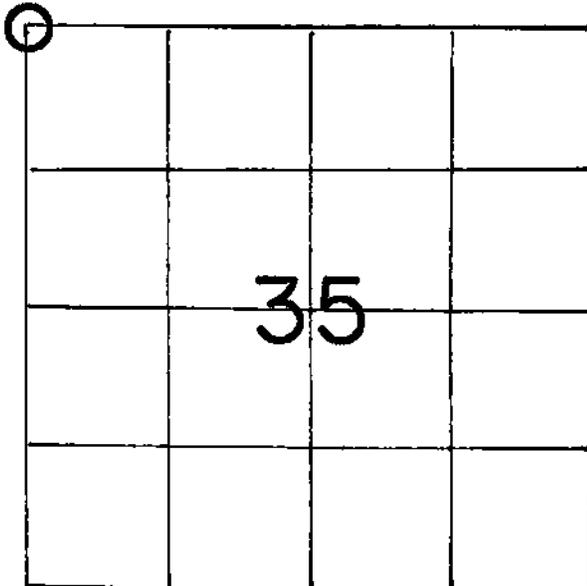

LOCATION OF LANDMARK

WISCONSIN COORDINATE SYSTEM

North

East

Theta Angle

Horiz. Order

Vert. Order

TYPE OF LANDMARK

Existing 2 1/4" Iron Pipe (O.D.)

BEARINGS ARE REFERENCED TO

True

Crew: WILLIAM C. JUNG
PETER F. FOLLANSBEE

Date: 12/02/1994

Describe any record evidence, monument evidence, testimonial evidence or any other material evidence you considered and whether the monument was found or restored through acceptance of an obliterated evidence location.


I found an iron pipe at the corner that had been used in previous survey work.. I accepted this pipe as the best available evidence of the original government corner position.

Describe or show any material discrepancy between the location of the restored corner and that of the corner previously restored or reestablished.

None Known.

RECORD OF DURABLE WITNESS MONUMENTS
True

NO	DESCRIPTION	BEARING	DISTANCE
1	Set 1" x 14" round Bar 1' E. of wood R/W post.	N 66° 27' 41" W	614.21 Ft.
2	Center of Telephone Box.	N 57° 58' 05" W	436.02 Ft.
3	Existing concrete, w/brass cap, GPS marker.	N 37° 47' 47" W	267.99 Ft.
4	Existing 2 1/4" Iron Pipe.	N 89° 48' 50" W	161.60 Ft.

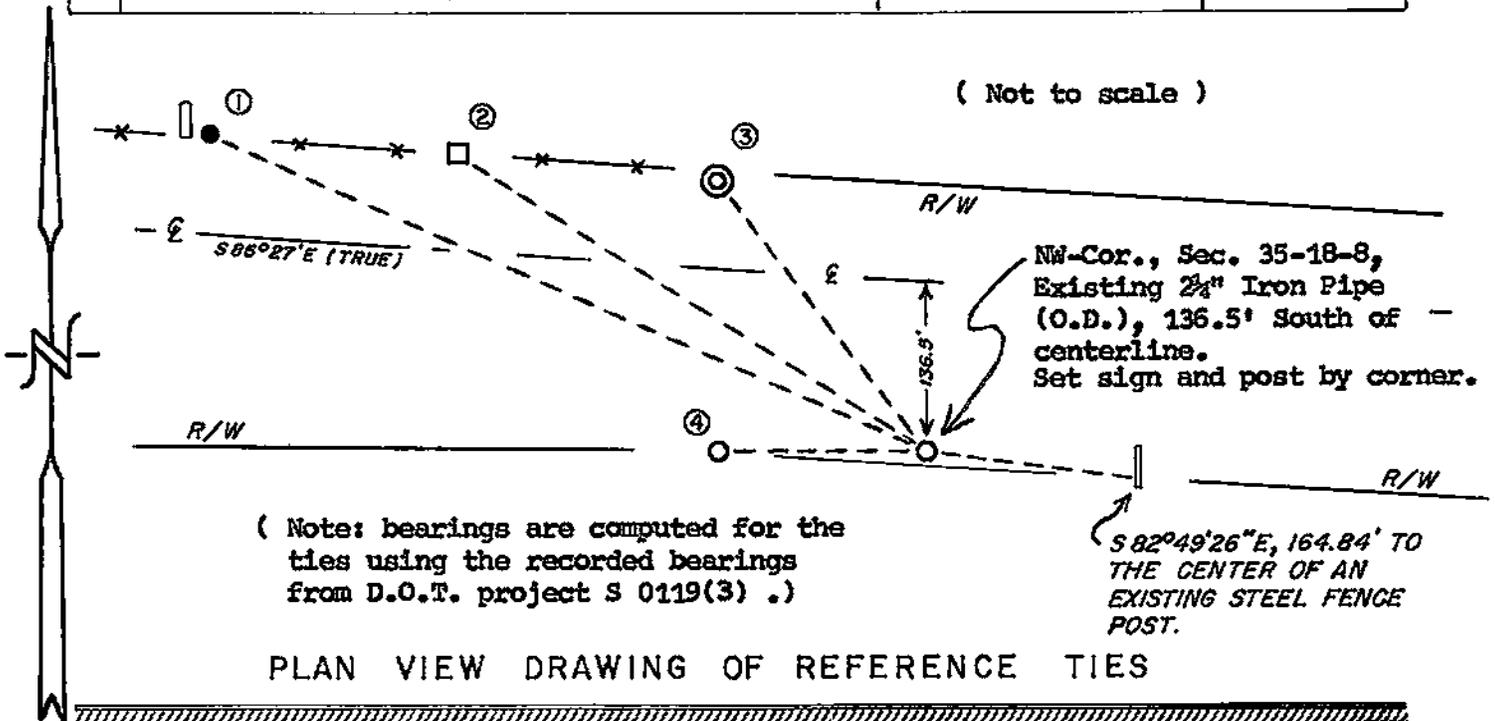


MAP SHOWING DISTANCE AND DIRECTION TO OTHER PUBLIC LAND SURVEY CORNERS USED FOR REESTABLISHING THE CORNER

No section measurements were made by me at this time. The position of this corner was confirmed by previous survey work.

I, William C. Jung, County Surveyor
HEREBY CERTIFY THAT THE CORNER LOCATION SHOWN ON THIS RECORD WAS DETERMINED BY ME OR UNDER MY DIRECTION AND CONTROL AND THAT THIS U. S. PUBLIC LAND SURVEY MONUMENT RECORD IS CORRECT AND COMPLETE TO THE BEST OF MY KNOWLEDGE AND BELIEF.

William C. Jung 3/6/95
Signature Date

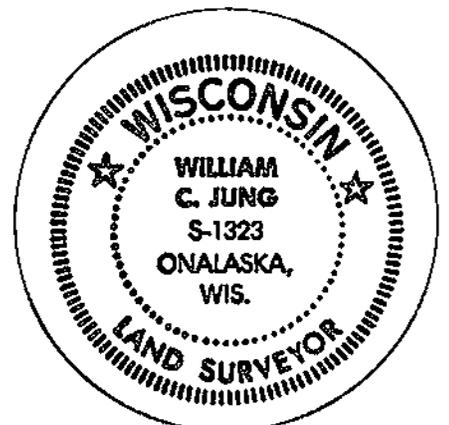

Seal