


## U. S. PUBLIC LAND SURVEY MONUMENT RECORD

SECTION 26 T 18 N, R 8 W, TOWN OF HOLLAND

LA CROSSE COUNTY

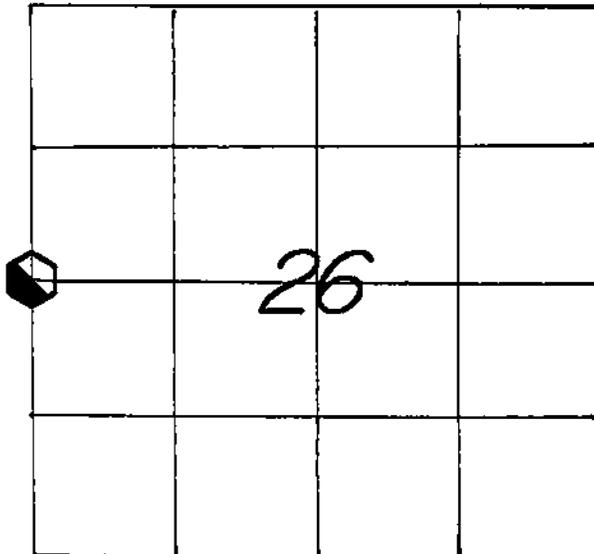

WISCONSIN COORDINATE SYSTEM

North

East

Theta Angle

Horiz. Order

Vert. Order

TYPE OF LANDMARK

**30" ALUMINUM BERNTSEN MARKER.**

BEARINGS ARE REFERENCED TO

**ASSUMED NORTH AS PER SECTION DATA.**

LOCATION OF LANDMARK

CREW: WILLIAM C. JUNG  
 PETER F. FOLLANSBEE  
 DATE: 10/17/2008

Describe any record evidence, monument evidence, testimonial evidence or any other material evidence you considered and whether the monument was found or restored through acceptance of an obliterated evidence location.


Rob Lampman set an iron pipe at this corner in 1980. I accepted Lampman's pipe as the corner, removed it, and replaced it with a Berntsen marker.

Describe or show any material discrepancy between the location of the restored corner and that of the corner previously restored or reestablished.


**NONE KNOWN.**

RECORD OF DURABLE WITNESS MONUMENTS

NO	DESCRIPTION	MAGNETIC	
		BEARING	DISTANCE
1	SET A NAIL IN N.-SIDE OF A 16-1/2" MAPLE	S 70° W	48.58 FT.
2	SET A NAIL IN S.W.-SIDE OF A 16-1/2" MAPLE	N 61° W	47.96 FT.
3	SET A NAIL IN S.W.-SIDE OF A 16" MAPLE	N 40° W	57.68 FT.
4	SET A NAIL IN N.W.-SIDE OF A 15" ASH	N 35° E	6.17 FT.

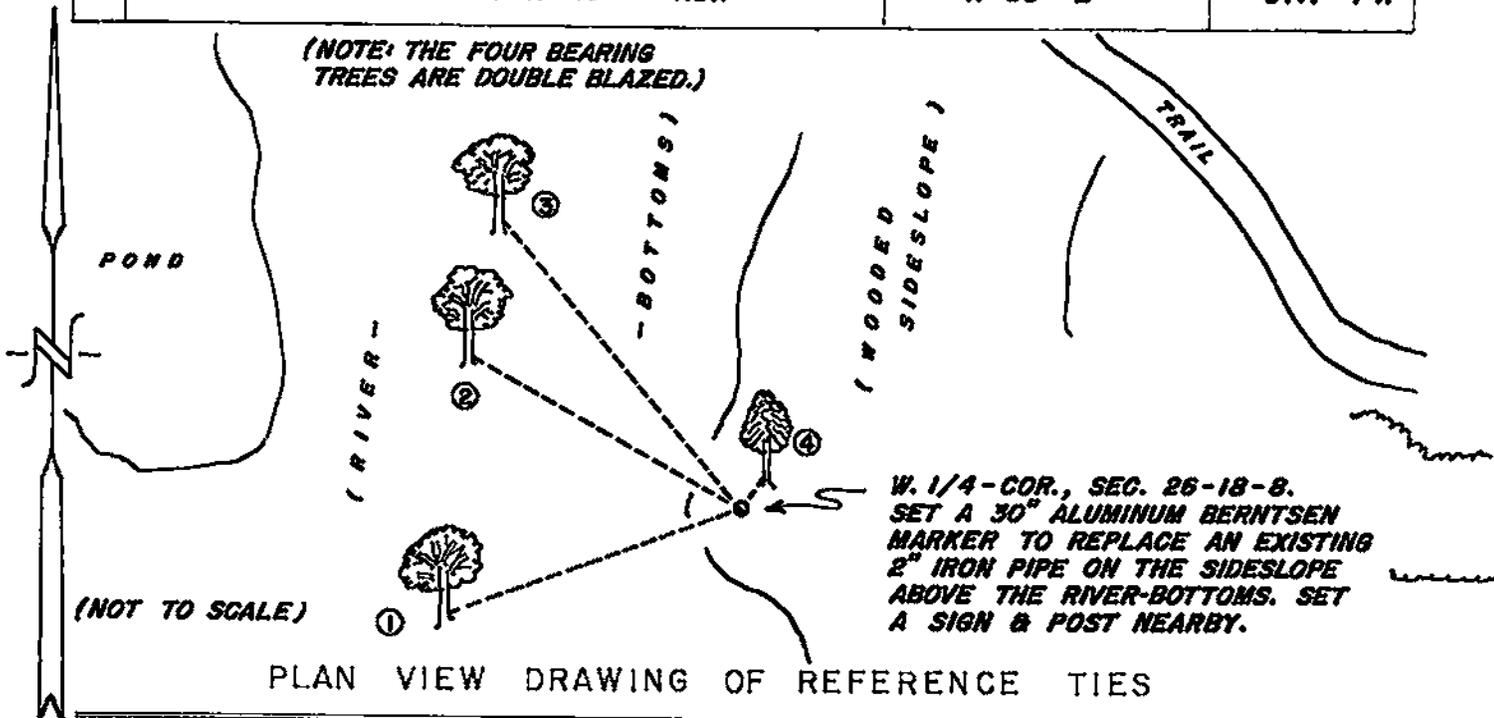


MAP SHOWING DISTANCE AND DIRECTION TO OTHER PUBLIC LAND SURVEY CORNERS USED FOR REESTABLISHING THE CORNER

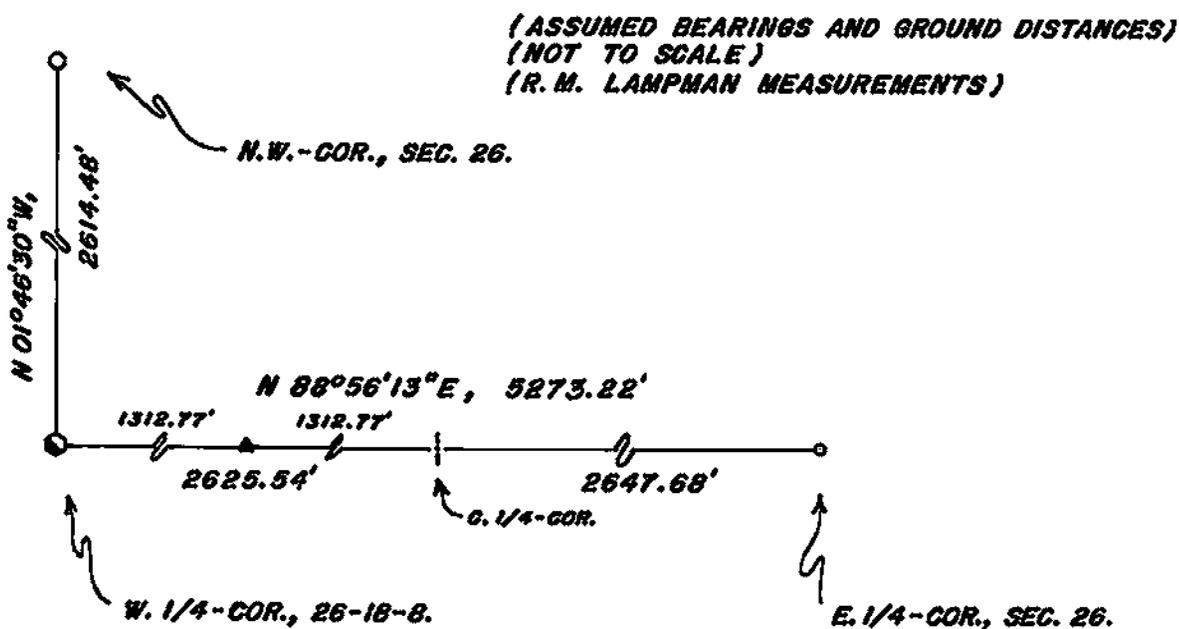

I, WILLIAM C. JUNG, COUNTY SURVEYOR  
HEREBY CERTIFY THAT THE CORNER LOCATION SHOWN ON THIS RECORD WAS DETERMINED BY ME OR UNDER MY DIRECTION AND CONTROL AND THAT THIS U. S. PUBLIC LAND SURVEY MONUMENT RECORD IS CORRECT AND COMPLETE TO THE BEST OF MY KNOWLEDGE AND BELIEF.

William C. Jung 10/29/08  
Signature Date

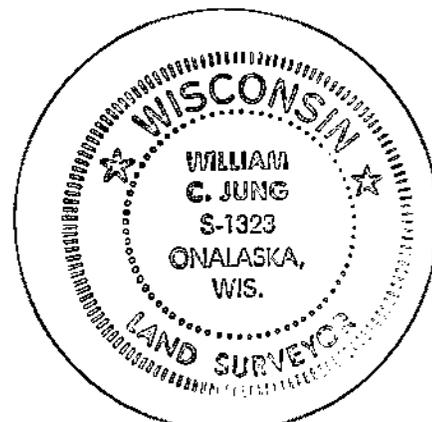

Seal