

21808280000

TREMPEALEAU COUNTY

U.S. PUBLIC LAND SURVEY MONUMENT RECORD

SECTION Corner common to Sections 27, 28, 33 & 34

T. 18 N., R. 8 W.

Type of monument 3" BRONZE CAPPED CONCRETE MONUMENT

Location indicated on sketch - \odot -

28	27
33	34

Location Sketch

Describe any record evidence, monument evidence, occupational evidence, testimonial evidence or any other material evidence you considered, and whether the monument was found or placed.

ORIGINAL GOVERNMENT ACCESSORIES WERE SEARCHED FOR, BUT NOTHING WAS FOUND. OTHER MONUMENT EVIDENCE WAS SEARCHED FOR, AND A 3" CONCRETE MONUMENT WITH A BRONZE CAP WAS FOUND. A 1-1/4" POINTED IRON BAR, WITH POINT UP, WAS FOUND 0.3 FEET SOUTHWESTERLY OF FOUND CONCRETE MONUMENT. ALSO FOUND U.S.B.S. BEARING TREE REMAINS. U.S.B.S. NOTES INDICATE FINDING A 1" IRON DRIFT PIN AT THIS CORNER LOCATION IN 1934. IN 1932, THE U.S.E.O. NOTES FINDING A 3" SQUARE STAKE, 3' FEET HIGH, AT THIS CORNER LOCATION. THE U.S.E.O. MARKED TWO BEARING TREES. THESE U.S.E.O. BEARING TREES WERE FOUND TO MATCH THE CONCRETE MONUMENT CLOSELY, INDICATING THAT THE DRIFT PIN WAS PROBABLY SET IN PLACE OF THE 3" SQUARE STAKE. THIS POSITION MATCHES THE U.S.E.O. DISTANCE TO THE SOUTHEAST CORNER OF SECTION 33-18-8 BY LESS THAN 2 FEET. IT MATCHES THE U.S.B.S. DISTANCE TO THE SOUTHEAST CORNER OF SECTION 33-18-8 BY LESS THAN 1 FOOT. IT ALSO MATCHES THE SPLIT OF DISTANCE BETWEEN THE NORTHEAST CORNER OF SECTION 28-18-8 AND THE SOUTHEAST CORNER OF SECTION 33-18-8 BY LESS THAN 1 FOOT. THEREFORE, BELIEVING FOUND CONCRETE MONUMENT, AS DESCRIBED, TO BE THE BEST AVAILABLE EVIDENCE OF THIS CORNER'S ORIGINAL LOCATION, IT WAS LEFT IN PLACE AND REFERENCED AS SHOWN BELOW.

Show a plan view drawing depicting the relevant monuments, providing reference ties to at least 4 witness monuments. Describe witness monuments. Show relationship to occupation.

o SET 5/8" X 24" REBAR WITH PLASTIC CAP

BEARINGS SHOWN TO THE NEAREST DEGREE ARE COMPASS BEARINGS OTHER BEARINGS ARE BASED ON THE TREMPEALEAU COUNTY COORDINATE SYSTEM


SURVEY SIGN POST 1' SOUTHEAST OF MON.



no scale

2' SOUTH OF 12" FACE BLAZED WHITE OAK

2' EAST OF 10" WHITE OAK

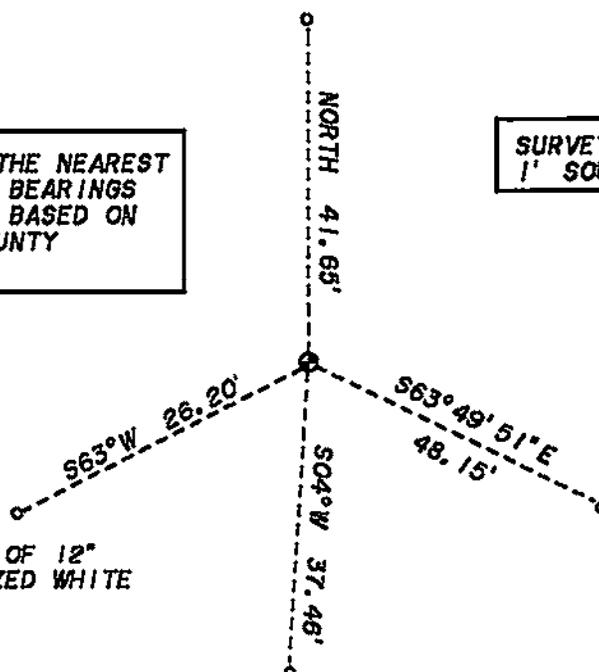

Corner Identifier number

72-328

Describe any material discrepancy between the location of the corner as restored or reestablished and the location of that corner as previously restored or reestablished by distance and direction. Show the discrepancy on the plan view drawing. Show the distances between the corner as restored or reestablished, and (1) the corner as restored or reestablished, and (2) to at least 2 of the witness monuments shown on the drawing.

NO MATERIAL DISCREPANCY WAS FOUND.

Was the corner restored through acceptance of (1) an obliterated evidence location, (2) a found perpetuated location, or (3) an existent corner location?

A FOUND PERPETUATED LOCATION.

Was the corner reestablished through lost corner proportionate methods? If so, show the method including the directions and distances to other public land survey corners used as evidence or used for proportioning in determining the corner location.

NO.

Show the corner history of record in chronological order from Original Government Survey to present.

**ORIGINAL GOVERNMENT SURVEY - CYRUS WOODWORTH - SEPTEMBER 1847
SET SECTION CORNER POST. MARKED TWO BEARING TREES.**

**UNITED STATES ENGINEER OFFICE - L. JENSEN - AUGUST 1932
SURVEYS FOR THE LOCK AND DAM SYSTEM ALONG THE MISSISSIPPI RIVER. NOTES A
FOUND 3" SQUARE, 3' HIGH STAKE, POSSIBLE NORTHEAST CORNER OF SECTION
33-18-8.**

**UNITED STATES BIOLOGICAL SURVEY - BURRELL - OCTOBER 1934
SURVEYS FOR WILDLIFE REFUGE NEAR THE MISSISSIPPI RIVER. NOTES A 1" SQUARE
DRIFT PIN, APPARENTLY FOUND, AT THE NORTHEAST CORNER OF SECTION 33-18-8.
SET A STANDARD U.S.B.S. CONCRETE POST AND MARKED TWO BEARING TREES.**

**CERTIFIED SURVEY MAP - G. DECHANT - FEBRUARY 1992
SURVEYS A PARCEL IN SECTION 33-18-8. CALLS FOR AN EXISTING CONCRETE
MARKER WITH A BRASS CAP NEXT TO A 1" DRIFT PIN AT THE NORTHEAST CORNER OF
SECTION 33. MARKS TWO BEARING TREES.**

Affix Land Surveyor Seal

I, JOSEPH P. NELSEN
certify that the corner location shown on this record
was determined by me or under my direction and control
and that this U.S. Public Land Survey Monument Record
is correct to the best of my knowledge and belief.

Joseph P. Nelsen 8-2-99
Signature Date

