

TREMPEALEAU COUNTY


U.S. PUBLIC LAND SURVEY MONUMENT RECORD

QUARTER Corner common to Sections 28 & 33

T. 18 N., R. 8 W.

Type of monument 7/8" X 80" REBAR WITH ALUMINUM CAP

Location indicated on sketch -  -

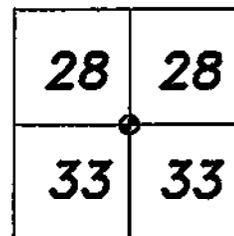


Location Sketch

Describe any record evidence, monument evidence, occupational evidence, testimonial evidence or any other material evidence you considered, and whether the monument was found or placed.

ORIGINAL GOVERNMENT ACCESSORIES WERE SEARCHED FOR, BUT NOTHING WAS FOUND. OTHER MONUMENT EVIDENCE WAS SEARCHED FOR, AND A 3", OUTSIDE DIAMETER, IRON PIPE WAS FOUND WITH A PINCHED TOP. THIS IRON PIPE MATCHES THE MATHEMATICAL POSITION AS INDICATED BY G. DECHANT SURVEY OF 1992. ACCORDING TO G. DECHANT SURVEY MAP, THIS POSITION WAS DETERMINED BY HOLDING THE LOCATION OF AN EAST/WEST FENCE LINE FOR NORTH/SOUTH POSITION AND PRORATING DISTANCE BETWEEN THE NORTHWEST CORNER OF SECTION 32-18-8 AND THE NORTHEAST CORNER OF SECTION 33-18-8 FOR THE EAST/WEST POSITION. FOUND IRON PIPE MATCHES THE EAST/WEST, PROPORTIONAL POSITION BY LESS THAN 0.1 FEET AND WAS FOUND TO BE ON A VERY REMNANT EAST/WEST FENCE LINE. THIS POSITION MATCHES LINE BETWEEN THE NORTHWEST AND NORTHEAST CORNERS OF SECTION 33-18-8 BY LESS THAN 6 FEET. THEREFORE, BELIEVING FOUND IRON PIPE, AS DESCRIBED, TO BE THE BEST AVAILABLE EVIDENCE OF THIS CORNER'S ORIGINAL LOCATION, A 7/8" X 80" REBAR WITH AN ALUMINUM CAP WAS SET IN ITS PLACE AND REFERENCED AS SHOWN BELOW.

Show a plan view drawing depicting the relevant monuments, providing reference ties to at least 4 witness monuments. Describe witness monuments. Show relationship to occupation.

o SET 5/8" X 24" REBAR WITH PLASTIC CAP

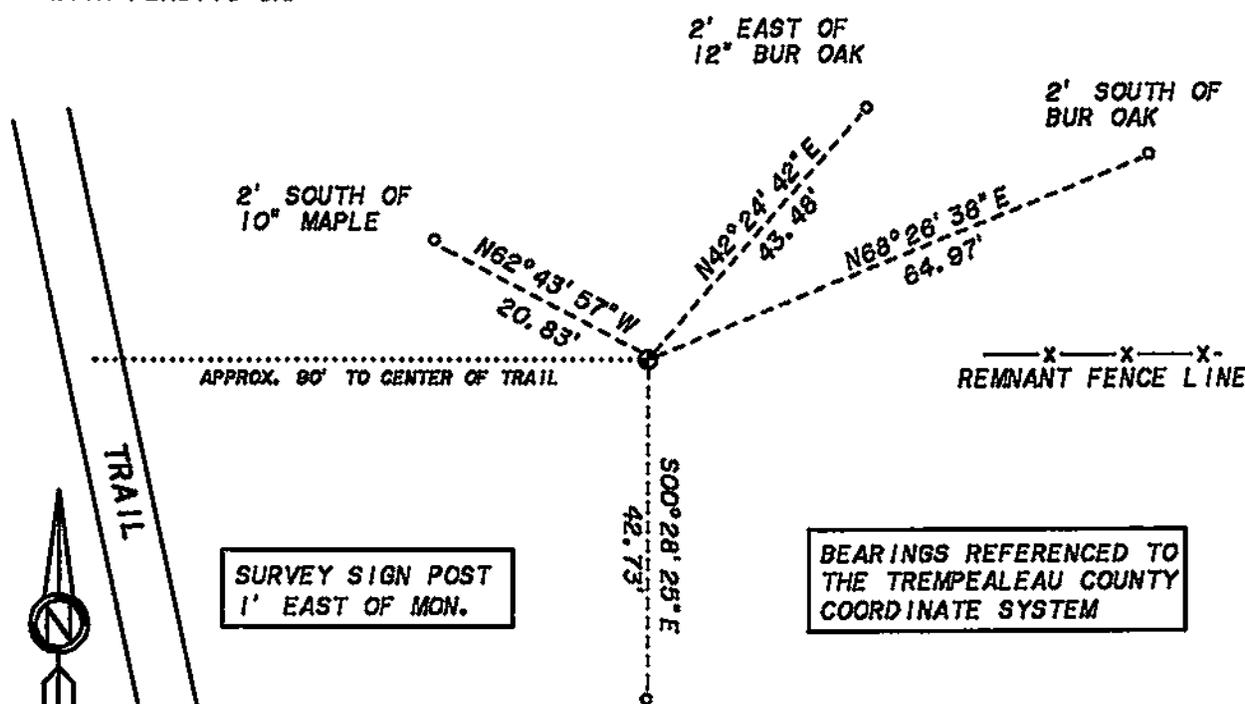

Corner Identifier number 76-328

no scale

Describe any material discrepancy between the location of the corner as restored or reestablished and the location of that corner as previously restored or reestablished by distance and direction. Show the discrepancy on the plan view drawing. Show the distances between the corner as restored or reestablished, and (1) the corner as restored or reestablished, and (2) to at least 2 of the witness monuments shown on the drawing.

NO MATERIAL DISCREPANCY WAS FOUND.

Was the corner restored through acceptance of (1) an obliterated evidence location, (2) a found perpetuated location, or (3) an existent corner location?

A FOUND PERPETUATED LOCATION.

Was the corner reestablished through lost corner proportionate methods? If so, show the method including the directions and distances to other public land survey corners used as evidence or used for proportioning in determining the corner location.

NO.

Show the corner history of record in chronological order from Original Government Survey to present.

**ORIGINAL GOVERNMENT SURVEY - CYRUS WOODWORTH - SEPTEMBER 1847
SET QUARTER SECTION POST. MARKED TWO BEARING TREES.**

**UNITED STATES ENGINEER OFFICE - WIELDE - AUGUST 1932
SURVEYS FOR LOCK AND DAM SYSTEM ALONG THE MISSISSIPPI RIVER.
TRAVERSES THE NORTH LINE OF SECTION 33-18-8. NOTES CALL FOR A EAST/WEST
FENCE LINE IN THE AREA OF THE NORTH QUARTER CORNER OF SECTION 33.**

**CERTIFIED SURVEY MAP - G. DECHANT - FEBRUARY 1992
SURVEYS PARCEL IN SECTION 33-18-8. CALLS FOR A SET 2" X 30" IRON PIPE AT
THE NORTH QUARTER CORNER OF SECTION 33. NOTES CORNER SET IN EAST/WEST
FENCE AT PRORATED DISTANCE.**

I, JOSEPH P. NELSEN
certify that the corner location shown on this record
was determined by me or under my direction and control
and that this U.S. Public Land Survey Monument Record
is correct to the best of my knowledge and belief.

Joseph P. Nelsen 7-20-99
Signature Date

Affix Land Surveyor Seal

